


DATE OCT 20 1997

TOWN OF LEXINGTON — BOARD OF PUBLIC WORKS
SEWER DIVISION

Sketch of Service Here

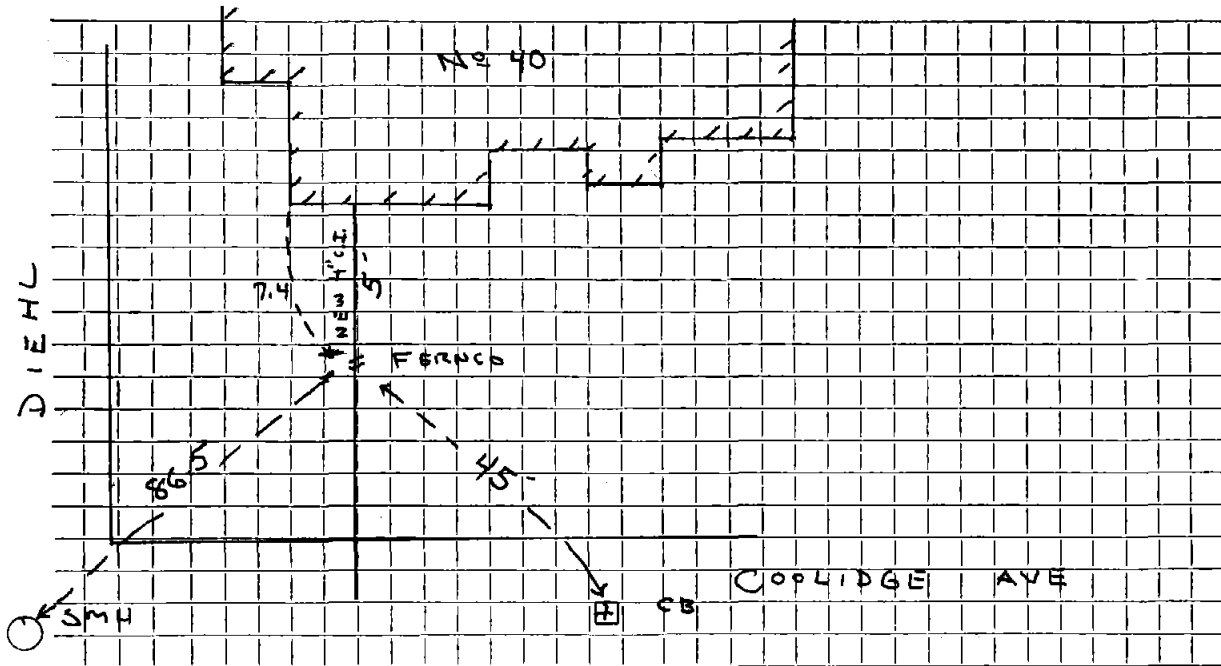

Connection made in COPLIDGE Street. Work completed C.M.I.N.A. CONT.

Remarks:

.....

..... FIELD BOOK 97-4 TIM