

Name CHESTNUT GREEN

Service No.

Address COPPERSMITH WAY (UNIT 1)

Location

Kind of Pipe P.V.C.

Size 6"

Size of Main

Repair—Renewal New Service CONTRACTOR - MELANSON

Location

Date	Material	Amount	Total	Date	Amount
------	----------	--------	-------	------	--------

OCT 4 99

30.7 6" PVC.

9' 4" PVC.

1 6x6 FERNCO

1 Y


1 CLEANOUT.

TJ

DATE OCT 4 1999

TOWN OF LEXINGTON — BOARD OF PUBLIC WORKS
SEWER DIVISION

Sketch of Service Here

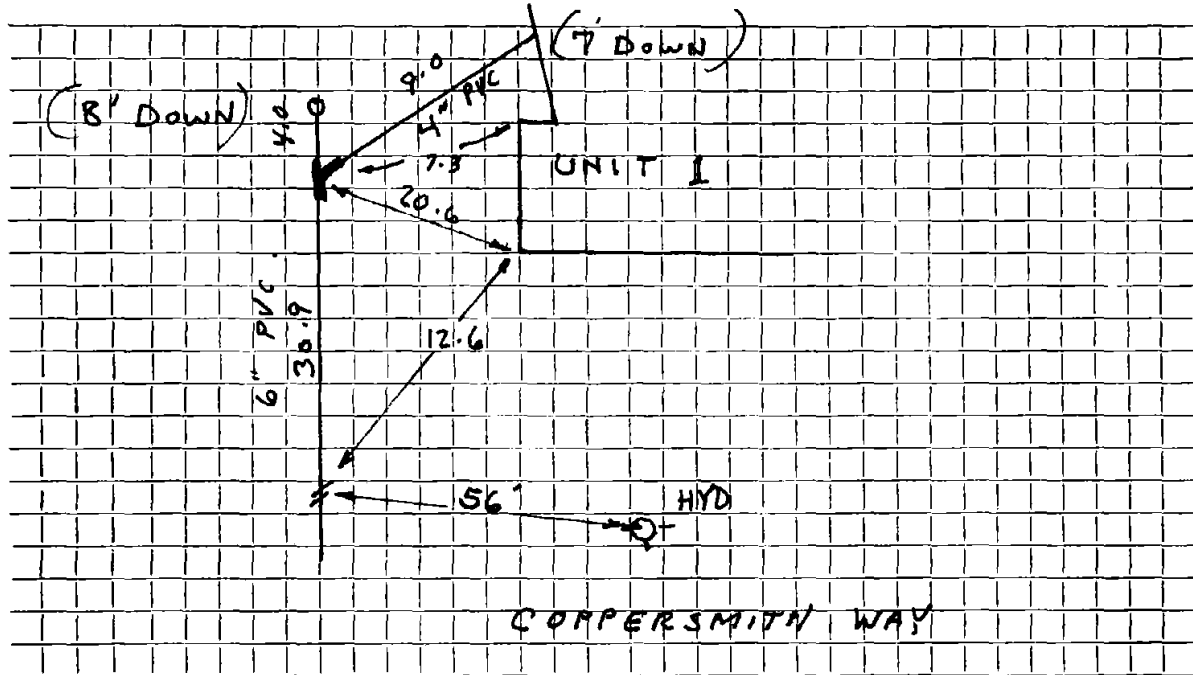

Connection made in COPPERSMITH WAY Street. Work completed

Remarks:
.....
.....