

Name CHESTNUT GREEN

Service No.

Address UNIT 2 COPPERSMITH WAY

Location

Kind of Pipe P.V.C

Size 6"

Size of Main

Repair—Renewal—~~New Service~~ CONTRACTOR: MALENSON

Location


Date	Material	Amount	Total	Date	Amount
				OCT 7 99	
					37.3' 6" P.V.C.
					1 CLEANOUT
					1 FERNCO



DATE OCT 7 1999

TOWN OF LEXINGTON — BOARD OF PUBLIC WORKS
SEWER DIVISION

Sketch of Service Here

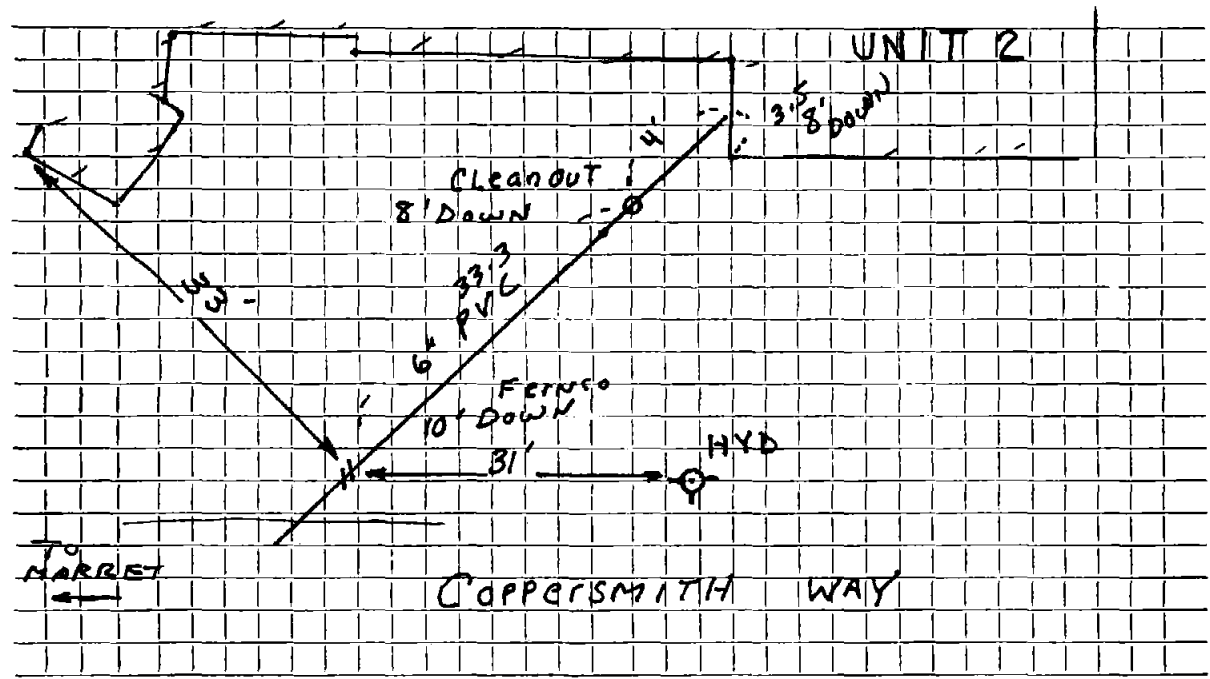

Connection made in COPPERSMITH WAY Street. Work completed

Remarks:
.....
.....