
_	A	T	_				
_	_		드	 	 	 	_

TOWN OF LEXINGTON -- BOARD OF PUBLIC WORKS

SEWER DIVISION

Sketch of Service Here

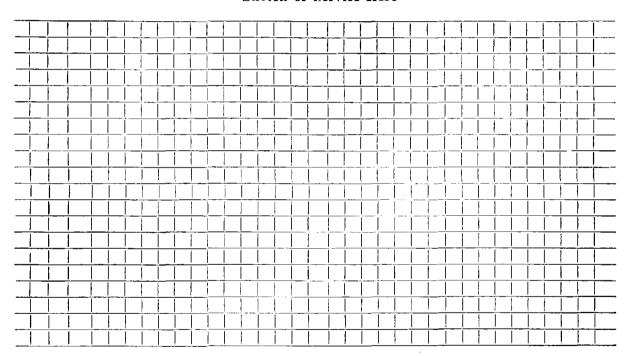

Connection made in Street.	work completed
Remarks:	
	.,
	,,,,,,,,,,,,,,,,,,,,,,,,,,,,,,,,,,,,,,,