

Name John Austin

Service No.

Address 28 Cottage Street

Location

Kind of Pipe

Size

Size of Main

~~REPAIR/RENEWAL~~ New Service Eagle #3596

Location

Date	Material	Amount	Total	Date	Amount
------	----------	--------	-------	------	--------

10-22-80	196' 6" P.V.C. pipe				
----------	---------------------	--	--	--	--

	1 Wye				
--	-------	--	--	--	--


	1 Precast Manhole				
--	-------------------	--	--	--	--

OUTSIDE

10-22-80	28' 6" P.V.C. Pipe				
	1 8" x 6" C.I. Saddle				

TOWN OF LEXINGTON — BOARD OF PUBLIC WORKS  
SEWER DIVISION

Sketch of Service Here **28**

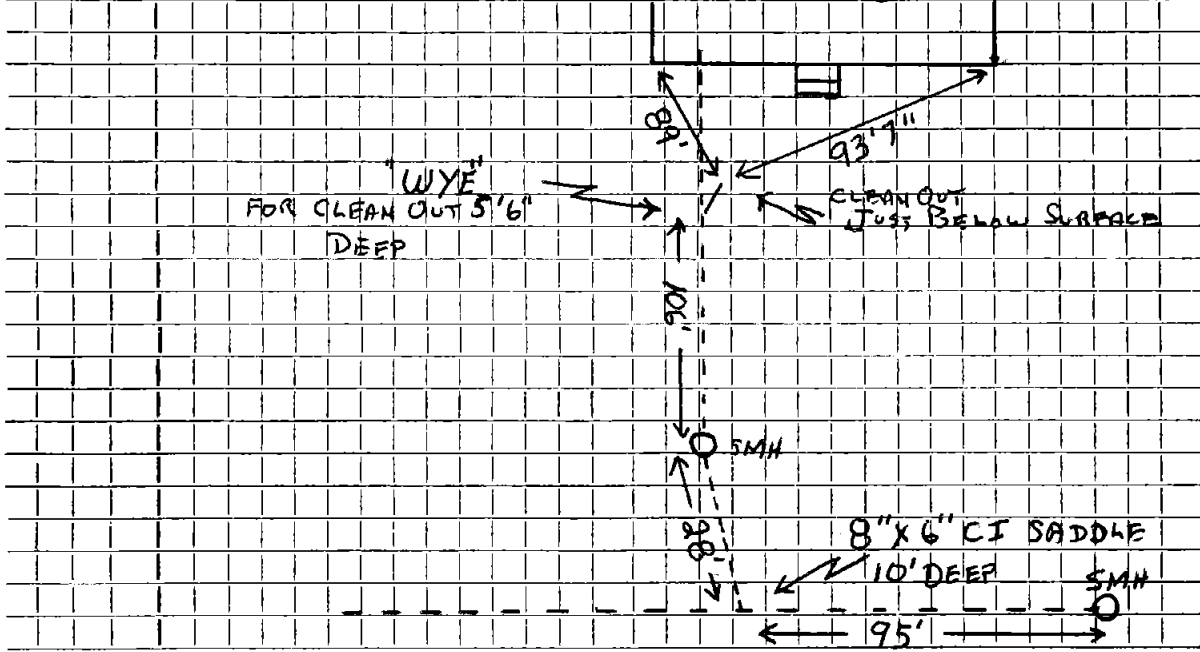

Connection made in \_\_\_\_\_ Street. Work completed \_\_\_\_\_

Remarks: ... WATER & SEWER IN SAME TRENCH ...

.....  
.....