

Name

Service No.

Address

30 Cottage Street

Location

Kind of Pipe

Size

Size of Main

Repair—Renewal—New Service

Location

Date

Material

Amount

Total

Date

Amount

11-22-26

10' 4" Soil Pipe

26' 4" Sewer Pipe

1 1/8" Bend


1-20-84 Roots 35' OUT

DATE _____

TOWN OF LEXINGTON — BOARD OF PUBLIC WORKS
SEWER DIVISION

Sketch of Service Here

30

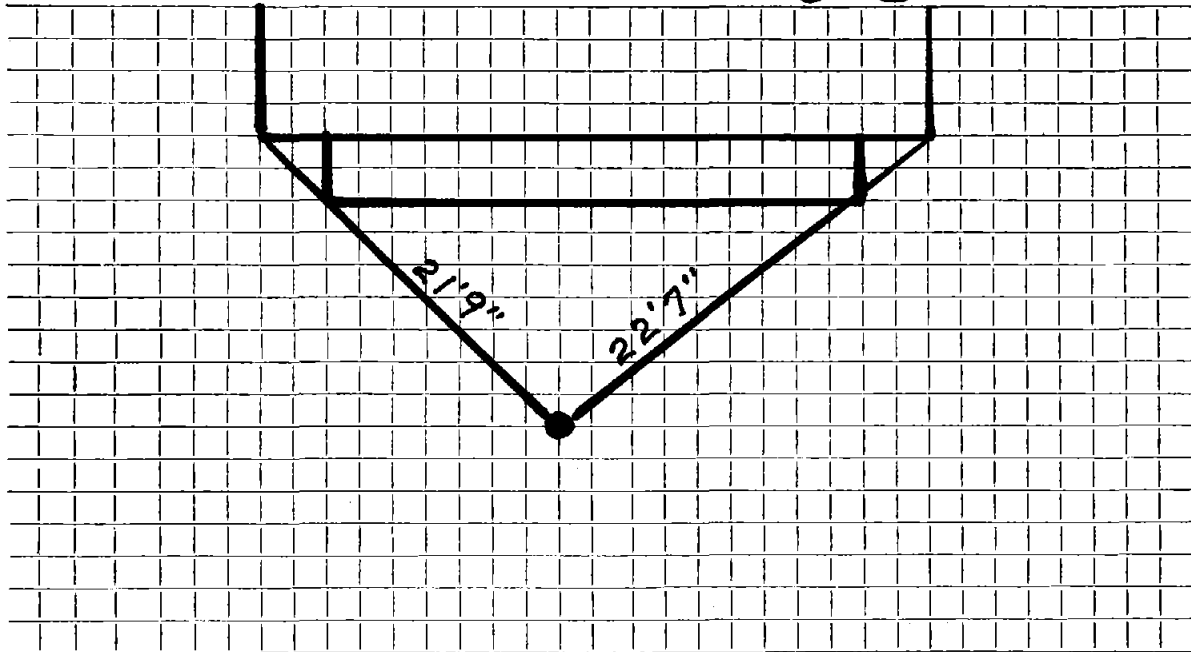

Connection made in Street. Work completed

Remarks:
.....
.....