

Name Stephen Donnellan

Service No. 21 201

Address 40 Cottage Street, Lexington

Location

Kind of Pipe

Size

Size of Main

~~Repair~~—Renewal—New Service

Location

Date 1938	Material	Amount	Total	Date	Amount
June 20 <i>Comer</i> <i>8-10-38</i>	18½ hrs. @ 55¢	10 18		August 1938	25 00
	10 " @ 60¢	6 00	16 80		
	10% Overhead		1 68		
	32' 6" Sewer Pipe @ 20¢		6 40	12-7-55	Repair 6' 6" Sewer Pipe
	1 6 x 6 y		1 00		
	1 6" Plug		10		
	Jointing Compound		1 92		
	2 hrs. trucking @ 75¢		1 50		
			29 40		
	Flat Rate:		\$25 00		
	Labor			10-19-90	Respond + measure
				5-11-67	Roots - Paper - Rags

Hadley Press, Inc., Lexington

TOWN OF LEXINGTON—BOARD OF PUBLIC WORKS

SEWER DIVISION

DATE June 11, 1938

NO. \_\_\_\_\_


The undersigned applies for the construction of a particular sewer connecting No. 40 Cottage St. Street and hereby agrees to comply with the Rules and Regulations governing the construction and use of Particular Sewers, as now or at any future time established by the Board of Selectmen.

Am't. of Estimate \$ 25.00

Am't. Paid \$ \_\_\_\_\_

Stephen Dornell Hau Owner

Sketch of Service Here

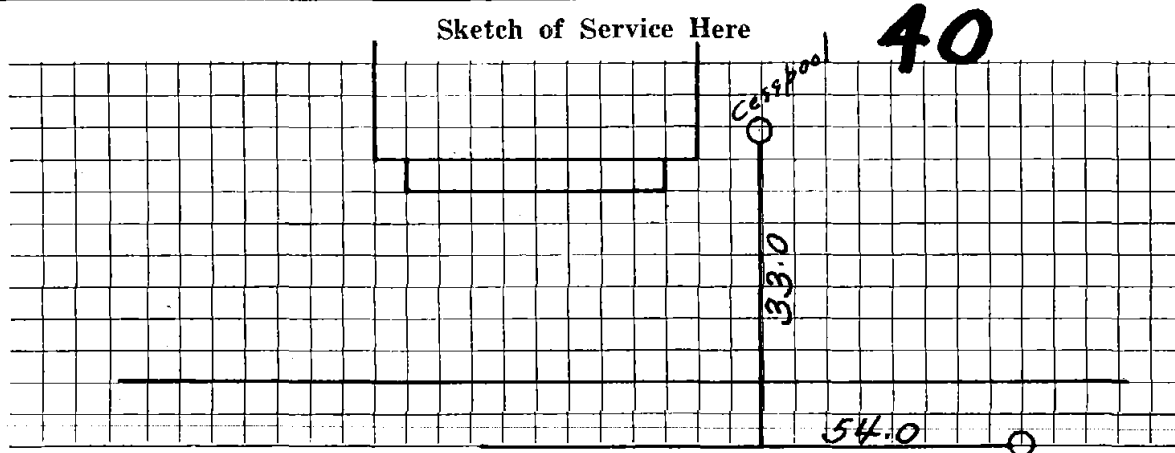

Connection made in \_\_\_\_\_ Street.

Work completed \_\_\_\_\_ 19

Remarks: