

Name Catherine Vaughan
 Address 5 Cottage Street,

Service No. 20 187

Location

Kind of Pipe

Size

Size of Main

Repair—Renewal—New Service

Location

Date 1939	Material	Amount	Total	Date	Amount
Dec. 20	54 hrs. @ 55¢	29 70		December 2, 1939 Deposited	40 00
<i>Nov 17-26-39</i>	42 " @ 60¢	25 20	54 90		
	10% Overhead		5 49		
	18' 6" Sewer Pipe @ 15¢		2 70		
	1 6" 1/4 Bend		62		
	Jointing compound		1 08		
	1 hr. compressor @ 3.00		3 00		
	2 hrs. trucking @ 75¢		1 50		
			<u>69 29</u>		
	Charge: \$40.00				
	Labor				

Hadley Press, Inc., Lexington

TOWN OF LEXINGTON—BOARD OF PUBLIC WORKS

SEWER DIVISION

DATE December 12, 1939

NO. _____


The undersigned applies for the construction of a particular sewer connecting No. 5 Cottage Street Street and hereby agrees to comply with the Rules and Regulations governing the construction and use of Particular Sewers, as now or at any future time established by the Board of Selectmen.

Am't. of Estimate \$ _____

Am't. Paid \$ _____

Owner

Sketch of Service Here

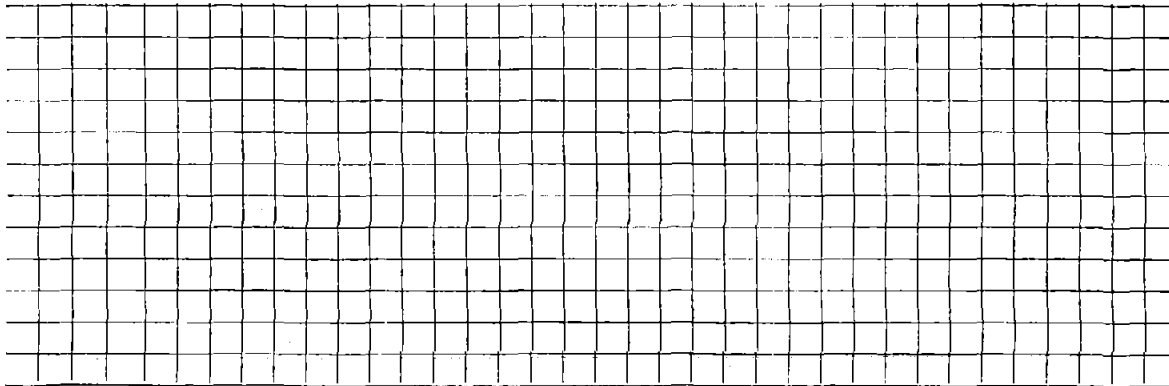

Connection made in _____ Street.

Work completed _____ 19

Remarks: