

Name

Service No.

Address 6 Cottage Street

Location

Kind of Pipe

Size

Size of Main

Repair—Renewal—New Service

Location

Date

Material

Amount

Total

Date

Amount

8-17-26

10' 4" Iron Pipe

36' 4" Sewer Pipe

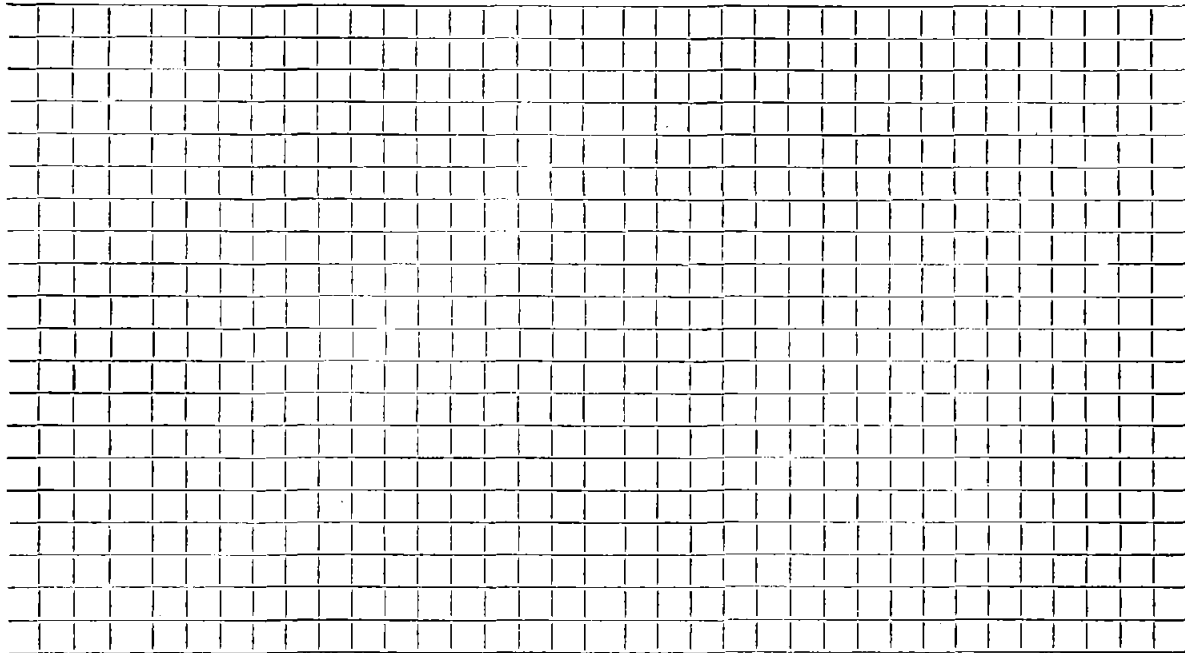
11-29-65 Paper + Debris

2-4-62 Sewer Block

DATE _____

TOWN OF LEXINGTON — BOARD OF PUBLIC WORKS
SEWER DIVISION

Sketch of Service Here

A large grid of graph paper, consisting of approximately 20 columns and 20 rows of small squares, intended for sketching service details.

Connection made in Street. Work completed

Remarks:
.....
.....