


DATE 4/07/00

TOWN OF LEXINGTON — BOARD OF PUBLIC WORKS
SEWER DIVISION

Sketch of Service Here

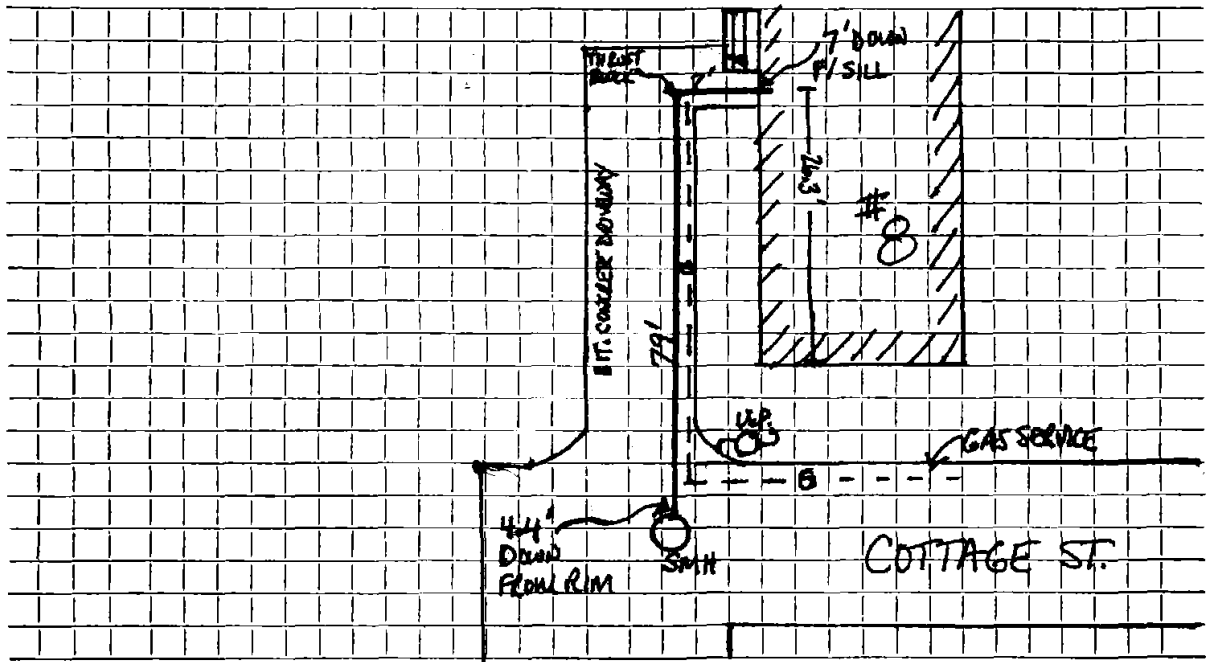

Connection made in Street. Work completed

Remarks: EXISTING GAS SERVICE IN SAME TRENCH/ BROKE/ REPAIRED BY BOSTON GAS

- 2" PVC INTO SEWER MANHOLE, 4-4" DOWN FROM RIM

- INVERT OUT OF HSE ~ 7' DOWN FROM SILL

INSPECTOR: DERRICK FULLERTON