

Name

Uticon Inc.

Service No.

Address

9 Cottage

Location

Kind of Pipe

SDR 35 PVC

Size

6"

Size of Main

Repair—Renewal—

New Service

Location

Date

Material

Amount

Total

Date

Amount

5/11/20


4" SDR 21 PVC
cleanout
4" x 6" FernCo
6" PVC Saddle

DATE 5/11/2020

TOWN OF LEXINGTON — BOARD OF PUBLIC WORKS

SEWER DIVISION

Sketch of Service Here

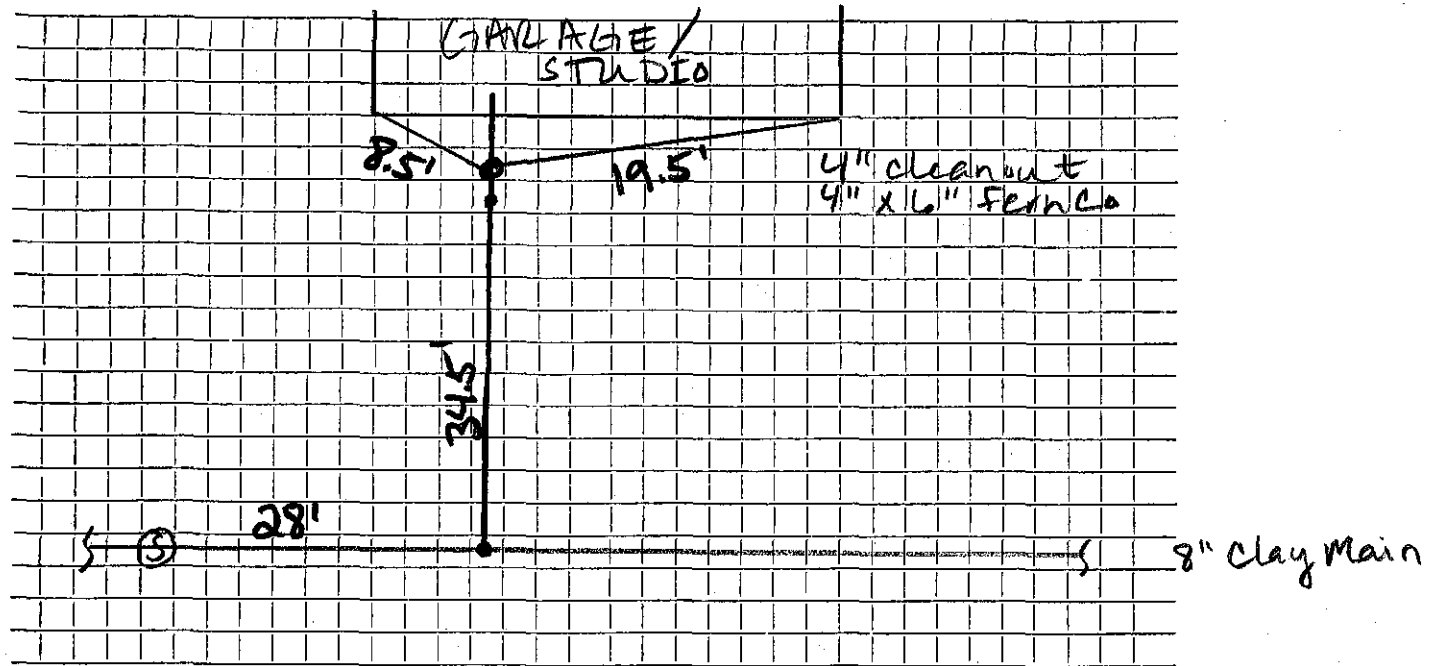

Connection made in Cottage Street. Work completed

Remarks: 6\" PVC saddle with 5' Chimney
12.5' to main 7' top chimney