

Name Moore Realty Trust

Service No. 1

Address 6 Crawford Road

Location

Kind of Pipe

Size

Size of Main

Repair—Renewal—New Service

Location *Comm 5-4-59*

Date	Material	Amount	Total	Date	Amount
3-9-59	Labor	23 30		3-5-59	<i>Deposit</i> 156 66
	10% O. H.	2 33	25 63	5-4-59	<i>Refund</i> 63 87
	52' 6" Transite Pipe @.70		36 40		86 13
	1 11 $\frac{1}{4}$ " Transite Elbow		2 24		
	1 22 $\frac{1}{8}$ " Transite Bend		6 21		
	1 6" Duplex Adapter		1 90		
	2 Hrs. Town Shovel @6.50		13 00		
	1 Hr. Trucking @.75		75		
			<u>86 13</u>		
	<b>Labor</b>				

**TOWN OF LEXINGTON—DEPT. OF PUBLIC WORKS  
SEWER DIVISION**

DATE.....

NO. ....

The undersigned applies for the construction of a particular sewer connecting No.....  
Street and hereby agrees to comply with the Rules and Regulations governing the construction and use of Particular  
Sewers, as now or at any future time established by the Board of Selectmen.


Am't of estimate \$.....

Am't Paid \$.....

..... Owner

---

**Sketch of Service Here**

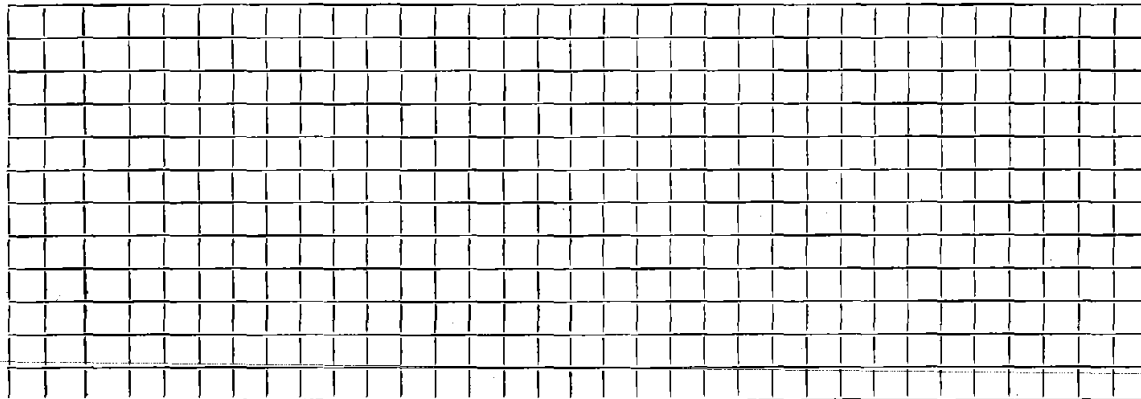

Connection made in..... Street.

Work completed.....19..

Remarks: