


DATE 6/26/90

TOWN OF LEXINGTON — BOARD OF PUBLIC WORKS
SEWER DIVISION

6" x 4" REDUCER
(PERNCO)

Sketch of Service Here

10

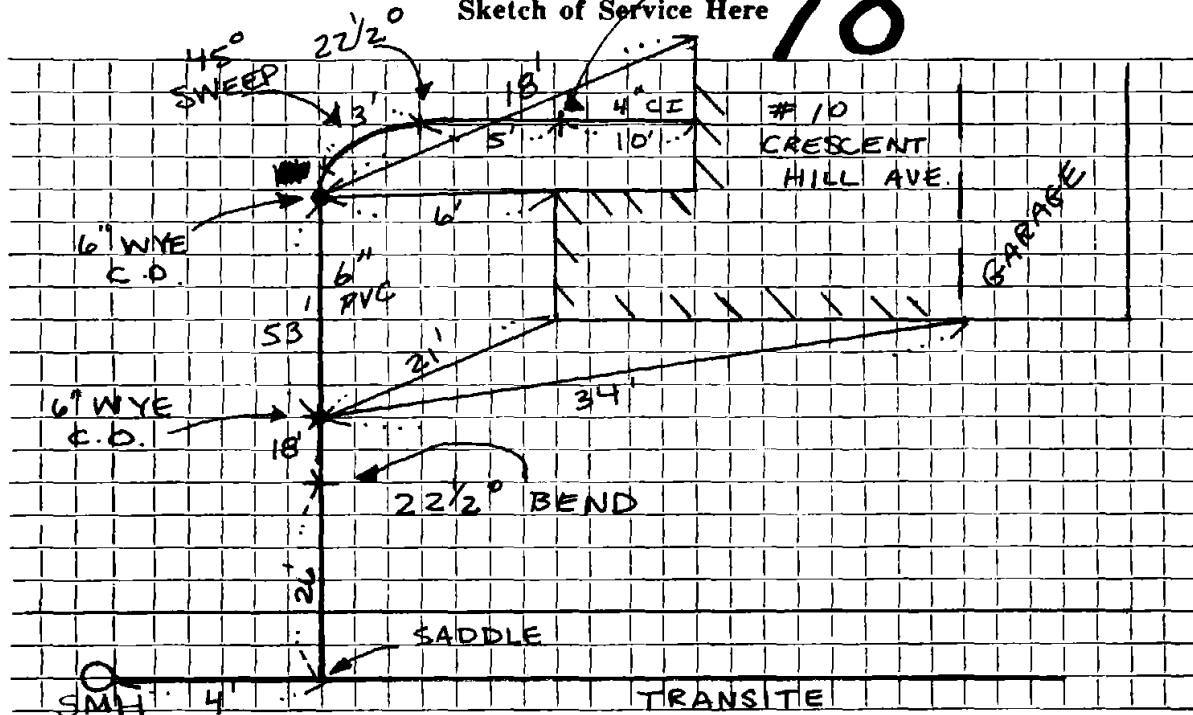

Connection made in ... CRESCENT HILL AVE Street. Work completed

Remarks: ... CONTRACTOR: VALERI CONSTRUCTION

INSPECTOR: P. BARROWS

.....