


TOWN OF LEXINGTON — BOARD OF PUBLIC WORKS
SEWER DIVISION

DATE _____

← 2' ←

Sketch of Service Here

#MS

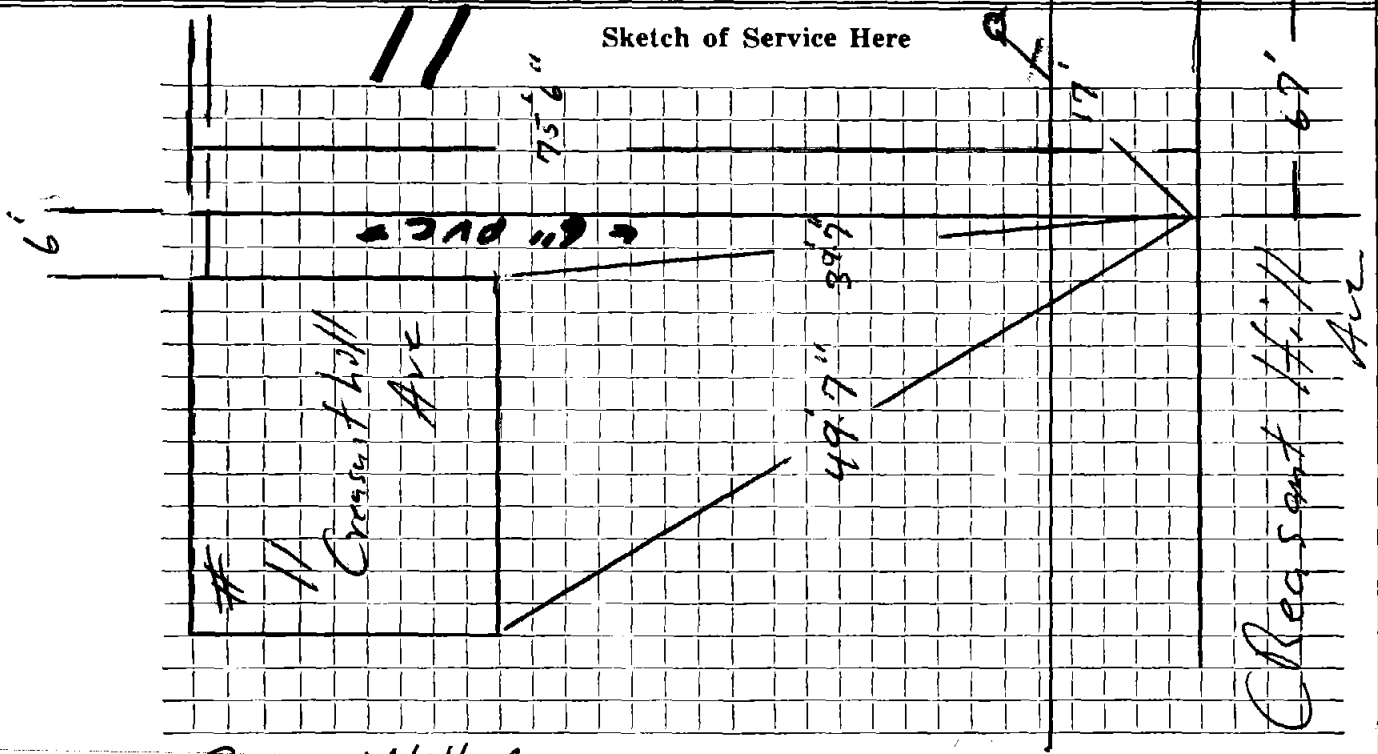

Connection made in Crescent Hill Ave. Street. Work completed

Remarks: cleanout is even with back of house, 6' out

.....
.....