

Name B. R. Nochella

Service No. 107

Address 131 Crescent Hill Avenue

Location

Comm. 11-18-57

Kind of Pipe

Size

Size of Main

Repair—Renewal—New Service

Location

| Date | Material | Amount | Total | Date | | Amount |
|---------|------------------------------|--------|--------|----------|---------------------------|----------|
| 8/22/57 | Labor | 74 70 | | 8-7-57 | Deposit | # 100 00 |
| | 10% overhead | 7 47 | 82 17 | 12-10-57 | Paid | 22 84 |
| | 14' - 6" Transite pipe @ .70 | | 9 80 | | | 122 84 |
| | 4' - 6" Clay pipe @ .435 | | 1 74 | | | |
| | 1 - 6" Clay Elbow | | 1 88 | | | |
| | 12x3 patch | | 12 00 | | | |
| | 2 hrs. Town Shovel @ 6.50 | | 13 00 | | | |
| | 3 hrs. Trucking @ .75 | | 2 25 | | | |
| | | | 122 84 | | | |
| | Labor | | | | | |
| | | | | | <i>Bill sent 11-21-57</i> | |

**TOWN OF LEXINGTON—DEPT. OF PUBLIC WORKS
SEWER DIVISION**

DATE.....

NO.


The undersigned applies for the construction of a particular sewer connecting No.....
Street and hereby agrees to comply with the Rules and Regulations governing the construction and use of Particular
Sewers, as now or at any future time established by the Board of Selectmen.

Am't of estimate \$

Am't Paid \$

..... Owner

Sketch of Service Here

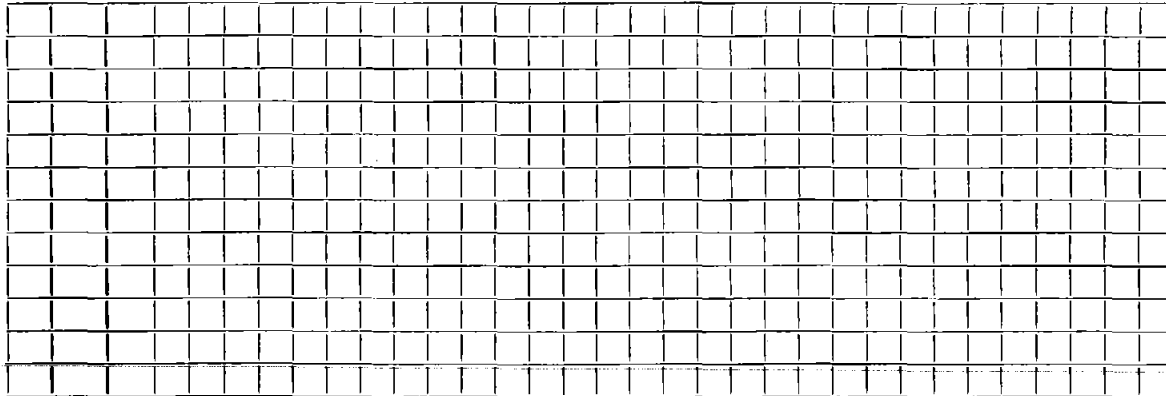

Connection made in Street.

Work completed 19..

Remarks: