

Name RICHARD J. DONOYAN

Service No.

Address #14 CRESCENT HILL AVENUE

Location

Kind of Pipe

Size

Size of Main

Repair—Renewal

New Service

PERMIT NO. 0954 - F.H.P. CONSTRUCTION

Location SEPTIC ABANDONMENT

Date

Material

Amount

Total

Date

Amount

MAY 12, 1997

108' - 6"  $\phi$  PVC


1 - 22° ELBOW

1 - WYE CLEANOUT

DATE MAY 12, 1997

TOWN OF LEXINGTON — BOARD OF PUBLIC WORKS  
SEWER DIVISION

Sketch of Service Here

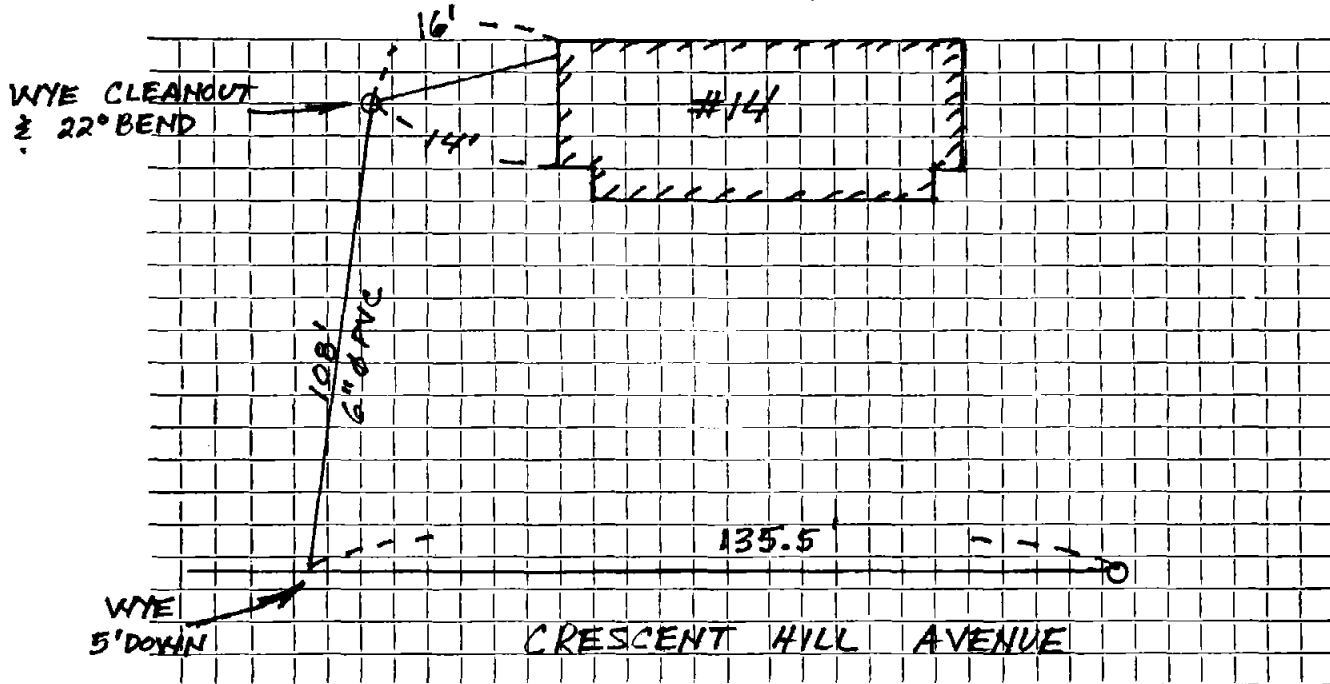

Connection made in ..... Street. Work completed .....

Remarks: .....

BOOK 97-2

J.W.