

Name Arthur W. Johnson

Service No. 46

Address 15A Crescent Hill Avenue

Location

Kind of Pipe

Size

Size of Main

~~Repair - Repair~~ New Service WO #7223


Location Comm. 7-16-62

Date	Material	Amount	Total	Date	Amount
5/17/62	Labor	66 35		5-8-62	200 00
	10% O.H.	6 64	72 99	7-16-62	38 17
	48' 6" Transite Pipe @ .78		37 44		161 83
	1 90° Transite Elbow		5 90		
	3 Hrs. Town Shovel @ 6.50		19 50		
	2 Hrs. Trucking @ 3.00		6 00		
	20 X 3 Patch		20 00		
			<u>161 83</u>		

DATE _____

TOWN OF LEXINGTON — BOARD OF PUBLIC WORKS
SEWER DIVISION

Sketch of Service Here

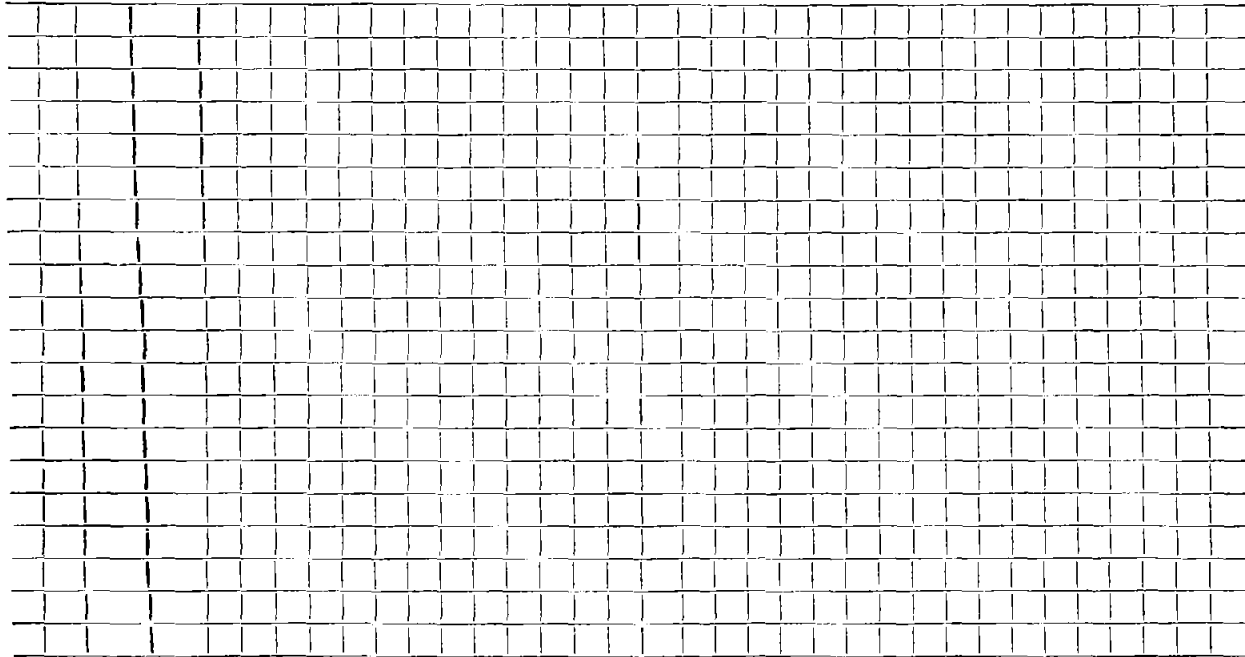

Connection made in Street. Work completed

Remarks:
.....
.....