

Name George Forbes

Service No. 174

Address 17 Crescent Hill Ave.

Location

Comm. 11-18-57

Kind of Pipe

Size

Size of Main

Repair ~~Renewal~~—New Service

Installed by contractor

Location

Date	Material	Amount	Total	Date	Amount
10/9/57	Labor	74 32		10-1-57 Deposit	\$ 150 00
	10% overhead	7 43		1-13-58 Paid	30 05
			81 75		\$ 180 05
	54' 6" transite @ .70		37 80		
	1 long bend		7 60		NON CHARGE
	1 short 90° bend		2 79		Labor
	6 8" clay pipe @.435		2 61		10% overhead
	4 hrs. Northwest shovel @6.50		26 00		Health welfare etc.
	14 x 3 patch		14 00		Hough Loader
	1 hr. compressor @3.00		3 00		Northwest shovel
	2 hrs. trucking @ .75		1 50		Trucking
	1 hr. Hough @ 3.00		3 00		
	Labor		180 05		

Bill sent 11-22-57
\$ 30.05

TOWN OF LEXINGTON—DEPT. OF PUBLIC WORKS

SEWER DIVISION

DATE.....

NO.


The undersigned applies for the construction of a particular sewer connecting No.....
 Street and hereby agrees to comply with the Rules and Regulations governing the construction and use of Particular
 Sewers, as now or at any future time established by the Board of Selectmen.

Am't of estimate \$.....

Am't Paid \$.....

..... Owner

Sketch of Service Here

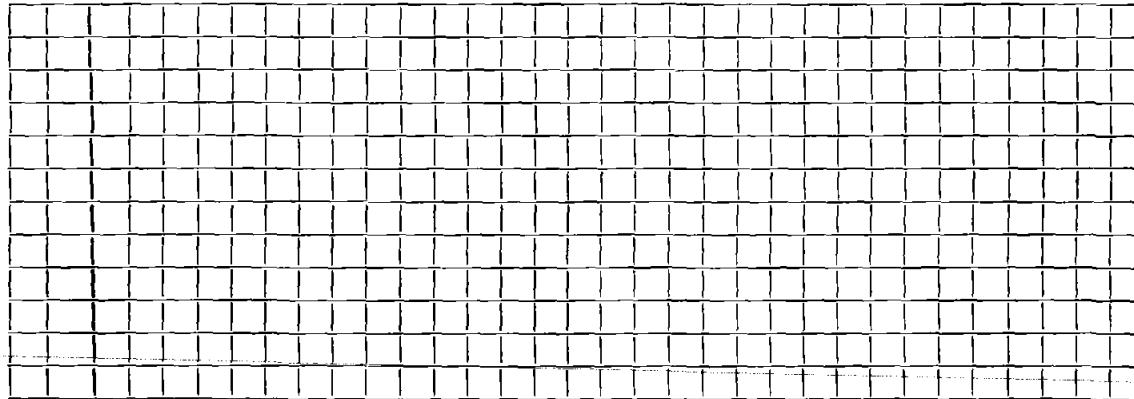

Connection made in..... Street.

Work completed.....19..

Remarks: