

Name **Edward Tocio**

Service No. **134**

Address **21 Crescent Hill Ave., Lexington, Ma**

Location

Comm. 12-2-57

Kind of Pipe

Size

Size of Main

~~Repair~~ **New Service**

Location

Date	Material	Amount	Total	Date	Amount
10-17-57	Labor	98 61		8-21-57 <i>Deposit</i>	\$ 250 00
10-18-57	Labor	57 36		7-23-58 <i>Paid</i>	55 30
	10% overhead	155 97 15 80	171 57		\$ 305 30
	78'-6" Transit te Pipe @ .70		54 60		
	1-6" Clay Elbow		1 88		
	1 Cesspool Cover & Frame		10 50		
	20 x 3 Patch		20 00		
	5 hrs. Town Shovel @ 6.50		32 50		
	3 hrs. Trucking @ .75		2 25		
	3 hrs. Hough @ 3.00		9 00		
	1 hr. Compressor @ 3.00		3 00		
			305 30		
	Labor				
				<i>Returned 12-11-57</i>	
				<i>\$ 55.30</i>	

TOWN OF LEXINGTON—DEPT. OF PUBLIC WORKS
SEWER DIVISION

DATE.....

NO.....


The undersigned applies for the construction of a particular sewer connecting No.....
Street and hereby agrees to comply with the Rules and Regulations governing the construction and use of Particular
Sewers, as now or at any future time established by the Board of Selectmen.

Am't of estimate \$.....

Am't Paid \$.....

..... Owner

Sketch of Service Here

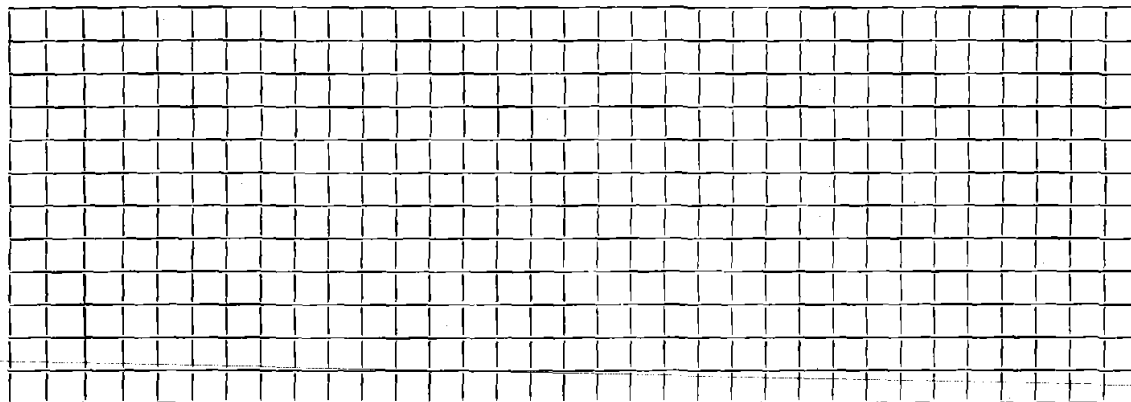

Connection made in..... Street.

Work completed.....19..

Remarks: