

Name Manuel Lima

Service No. 119

Address 23 Crescent Hill Avenue

Location

Comm. 11-18-57

Kind of Pipe

Size

Size of Main

~~Repair~~—~~Renewal~~—New Service

Location

Date	Material	Amount	Total	Date		Amount
8/20/57	Labor	74 70		8-15-57	Deposit	\$ 250 00
8/21/57	"	66 08		11-18-57	Refund	4 93
		140 78				\$ 245 07
	10% overhead	14 08	154 86			
	73' - 6" Transite Pipe @ .70		51 10			
	1 - 6" 11 $\frac{1}{4}$ " Bend		2 24			
	1 - 6" Clay Elbow		1 88		REPAIR - W.O. #4162	
	4' - 6" Clay pipe @ .435		1 74	3/13/67	Labor	115 92
	12x3 Patch		12 00		8' Transite pipe @ .88	7 04
	2 hrs. Town Shovel @ 6.50		13 00		1 Elbow	4 09
	2 hrs. Compressor @ 3.00		6 00		8500 lbs. stone	7 01
	3 hrs. Trucking @ .75		2 25		3 Hrs. Trucking @ 3.00	9 00
	Labor		245 07		1 Hr. Compressor	5 00
					3 Hrs. Shovel @ 6.50	19 50
						167 56

**TOWN OF LEXINGTON—DEPT. OF PUBLIC WORKS**  
**SEWER DIVISION**

DATE.....

NO. ....


The undersigned applies for the construction of a particular sewer connecting No.....  
Street and hereby agrees to comply with the Rules and Regulations governing the construction and use of Particular  
Sewers, as now or at any future time established by the Board of Selectmen.

Am't of estimate \$.....

Am't Paid \$.....

..... Owner

**Sketch of Service Here**

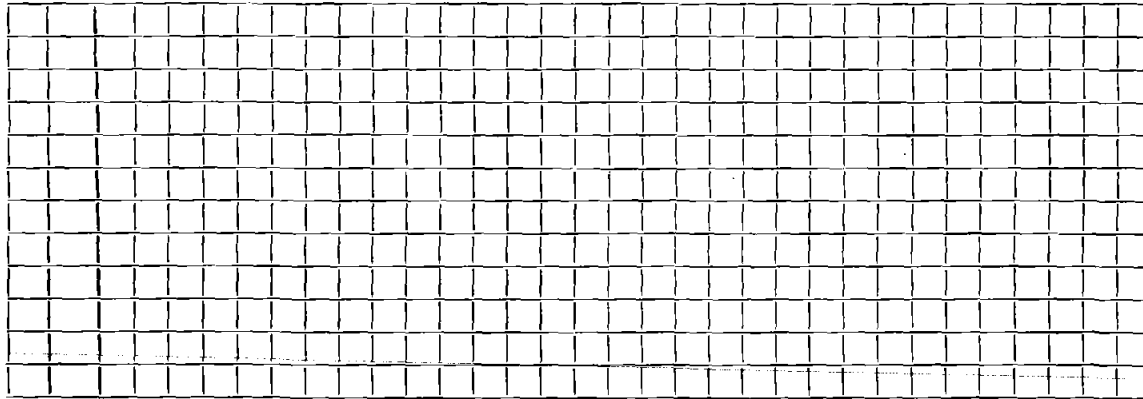

Connection made in ..... Street.

Work completed.....19..

Remarks: