

Name CHRISTINE AVERY

Service No.

Address 9 CRESCENT HILL AVE

Location

Kind of Pipe 6" P.V.C.

Size 6"

Size of Main

~~Repair~~ ~~Renewal~~ ~~New Service~~

Contractor: P.H.D. Permit No. 1210  
D.S. No. 990704139

Location

Date	Material	Amount	Total	Date	Amount
------	----------	--------	-------	------	--------

FEB 19 99

23' 6" P.V.C.

3 22 1/2" BEND


1 FERN CO

TJM

DATE FEB 19 1999

TOWN OF LEXINGTON — BOARD OF PUBLIC WORKS  
SEWER DIVISION

Sketch of Service Here

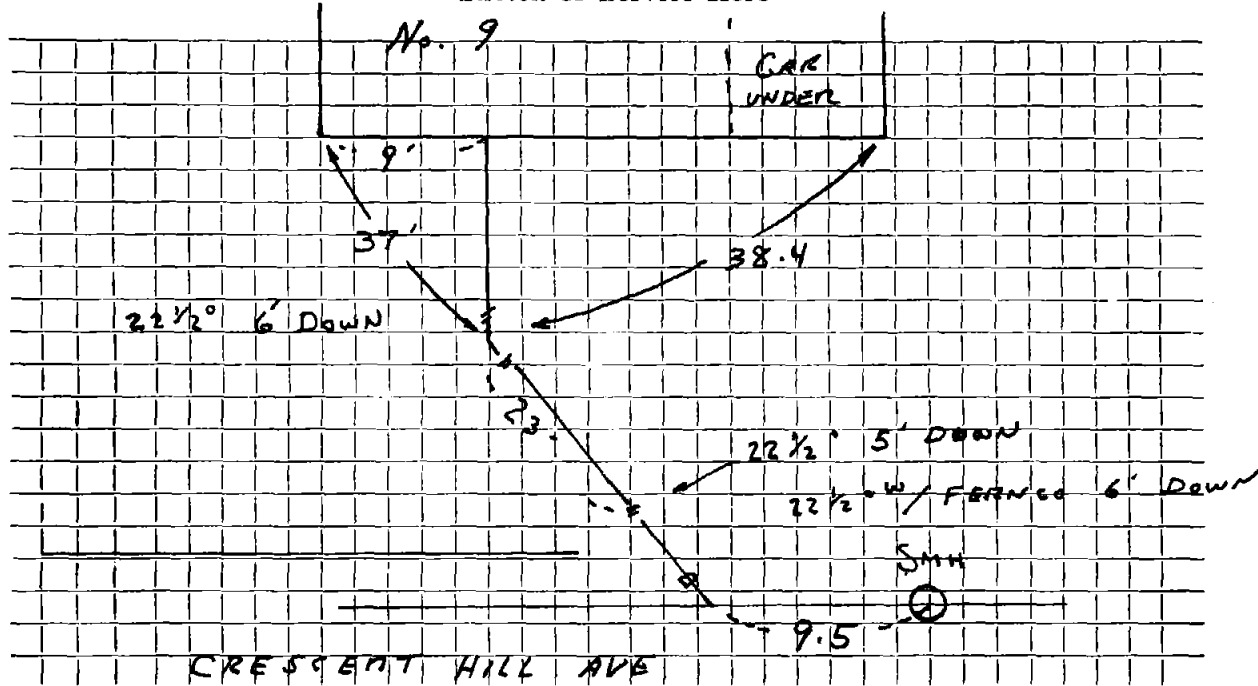

Connection made in Crescent Hill Ave. Street. Work completed .....

Remarks: .....

TJW