

Name Arthur Ritchie, Jr.

Service No. 29

Address #11 CRESCENT RD

Location

Kind of Pipe AC

Size 6"

Size of Main 8"

Repaired ~~Revised~~ New Service Valeri #4084

Location OCT 25 1982

Date	Material	Amount	Total	Date	Amount
8/18/78	29' x 6" ACP	@ \$14.00 =	\$406.00	9-14-82	406.00
9/24/82	91' 6" P.V.C.				
	1 30° P.V.C. Elbow			8-18-78	
	2 22½° P.V.C. Elbow			29' 6" P.V.C.	
	1 P.V.C. x ACP Adaptor				
	1 4" x 6" Donut				
	20" Frame & Cover				
	300 Red Sewer Brick				

Deposit


406.00

DATE 9-24-82

TOWN OF LEXINGTON — BOARD OF PUBLIC WORKS

SEWER DIVISION

Sketch of Service Here

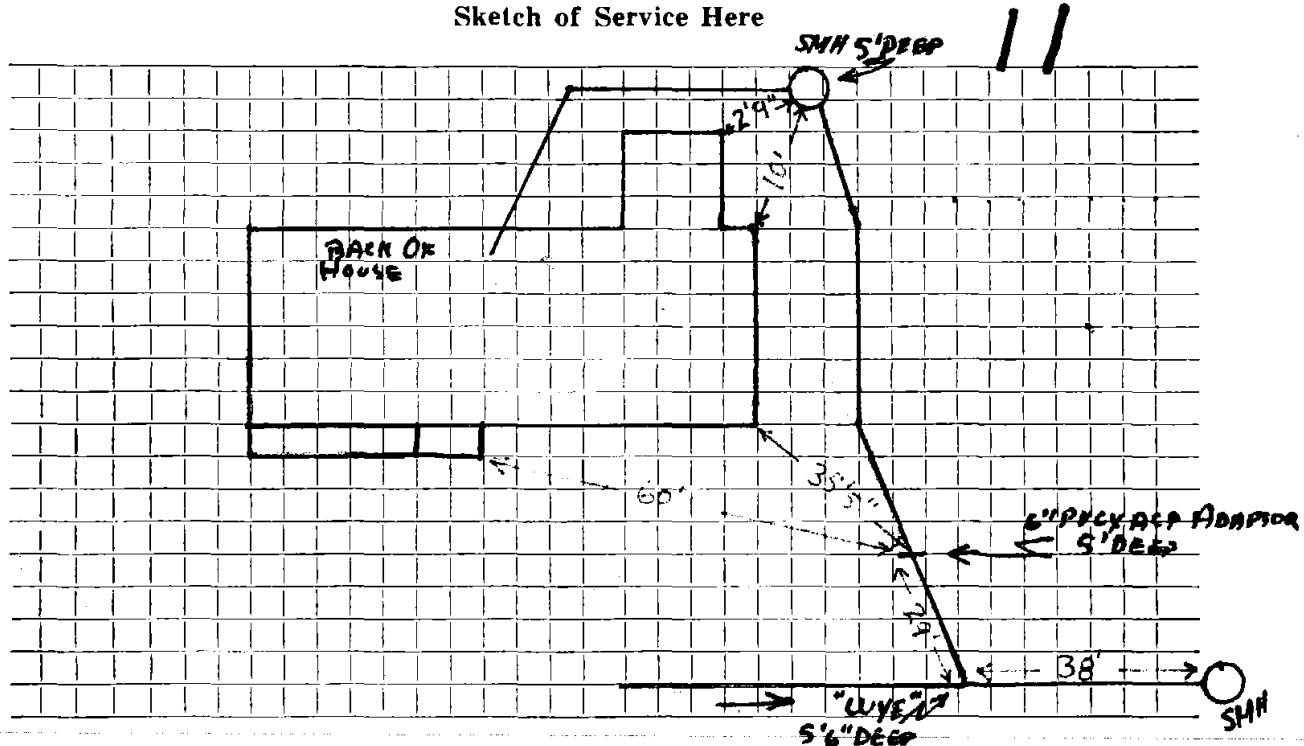

Connection made in Street. Work completed

Remarks: 27'x6" PVC FROM CAST IRON (HOUSE) TO MANHOLE IN YARD — 64'x6" PVC FROM MANHOLE TO PROPERTY LINE...