




DATE 9-26-'90

TOWN OF LEXINGTON — BOARD OF PUBLIC WORKS  
SEWER DIVISION

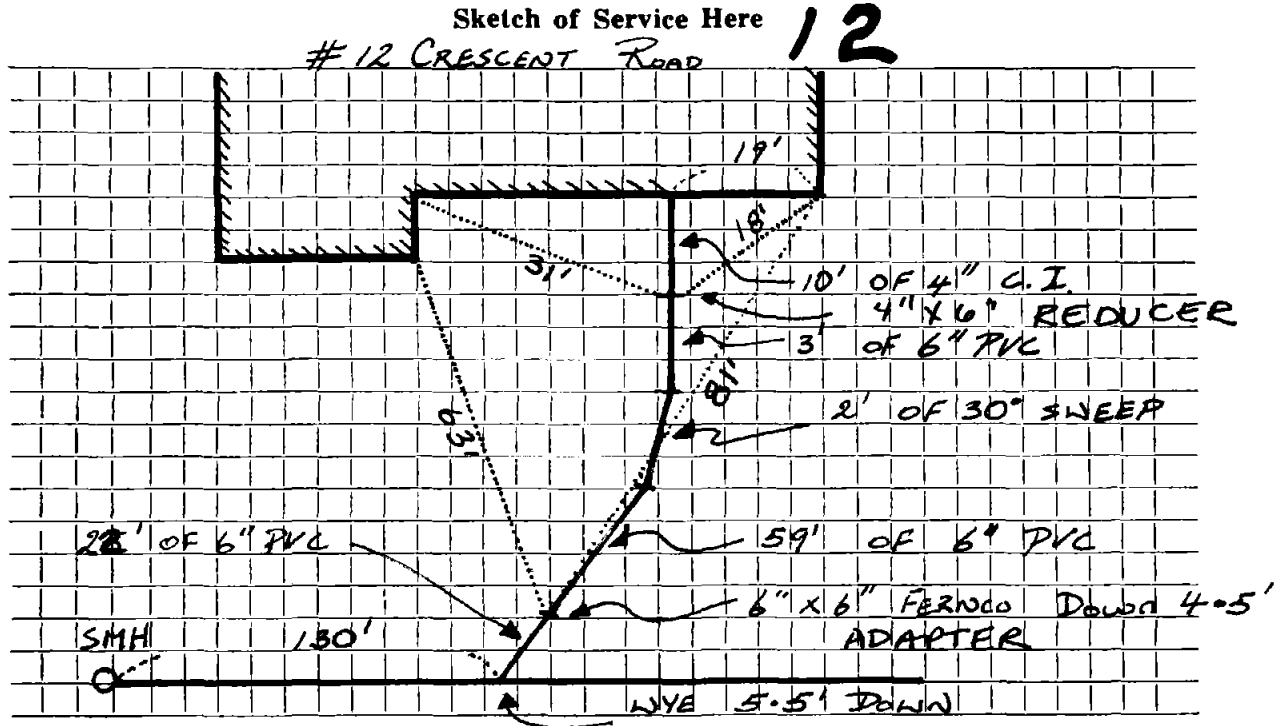

Connection made in ..... Street. Work completed .....

Remarks: INSPECTED 9-26-'90 BY S. MACKAY INSTALLED BY VALERI CONSTR.