


DATE APRIL 14, 1997

TOWN OF LEXINGTON — BOARD OF PUBLIC WORKS

SEWER DIVISION

Sketch of Service Here **15**

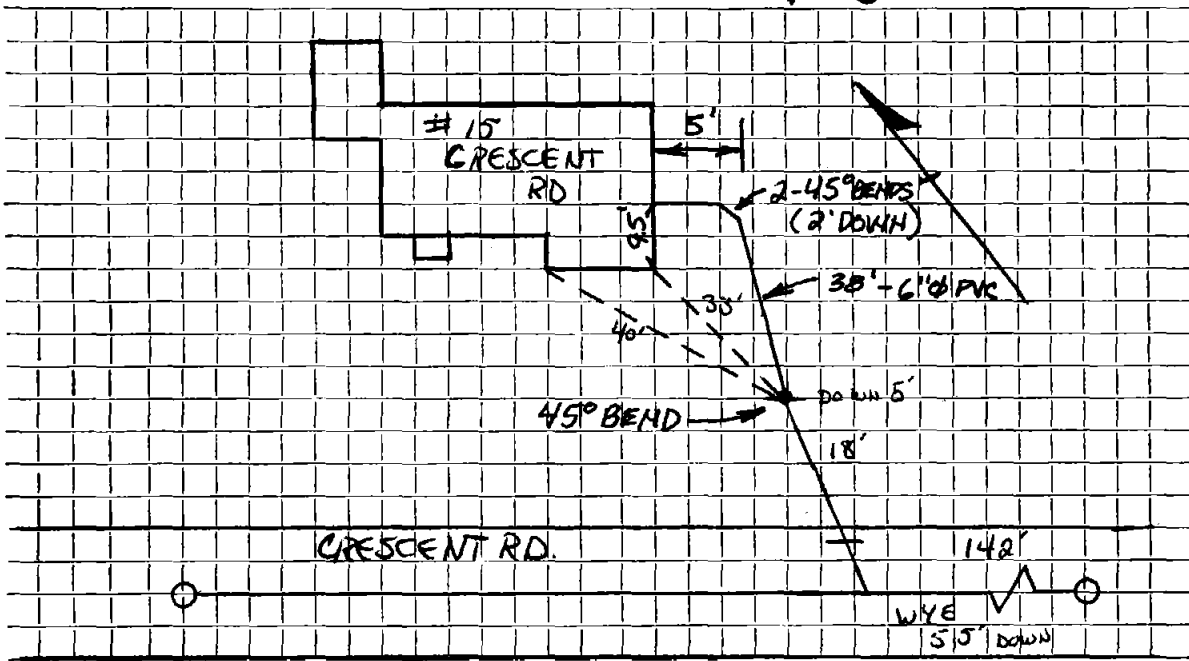

Connection made in CRESCENT ROAD Street.

Work completed SUBURBANITE CESSPOOL SERVICE

Remarks:

BOOK 97-1

J.W.