

7

DATE 7/11/90


TOWN OF LEXINGTON — BOARD OF PUBLIC WORKS

G.T.S.

SEWER DIVISION

Sketch of Service Here

20

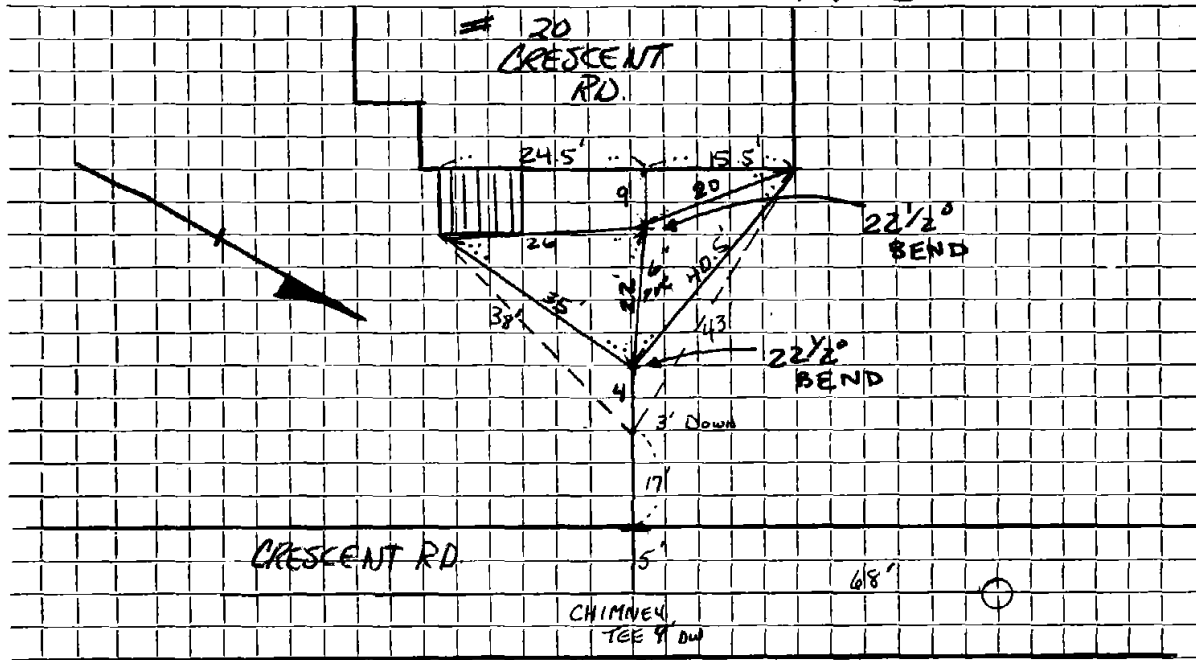

Connection made in CRESCENT Rd. Street. Work completed

Remarks: .. CONTRACTOR: .. SUBURBANITE ..

..... INSPECTED: .. G.T. SAMAHA ..