

Name *Richard Balmer*

Service No. *81*

Address *22 Crescent Rd*

Location

Kind of Pipe *AC*

Size *6"*

Size of Main *8"*

~~Repair~~ ~~Renewal~~ ~~New Service~~ *Trebino #3094*

Location *NOV 13 1978*


Date	Material	Amount	Total	Date	Amount
8/18/78	16' 6" Transite Pipe @14.00			<i>10-23-78</i>	<i>Deposit</i>
			<i>224.00</i>		<i>224.00</i>
<i>11/3/78</i>	<i>48' 6" Transite Pipe</i>				
	<i>10' 4" Cast Iron Pipe</i>			<i>8-18-78</i>	
				<i>16' 6" Transite</i>	

H.R.E. 18501

DATE _____

TOWN OF LEXINGTON — BOARD OF PUBLIC WORKS
SEWER DIVISION

Sketch of Service Here **22**

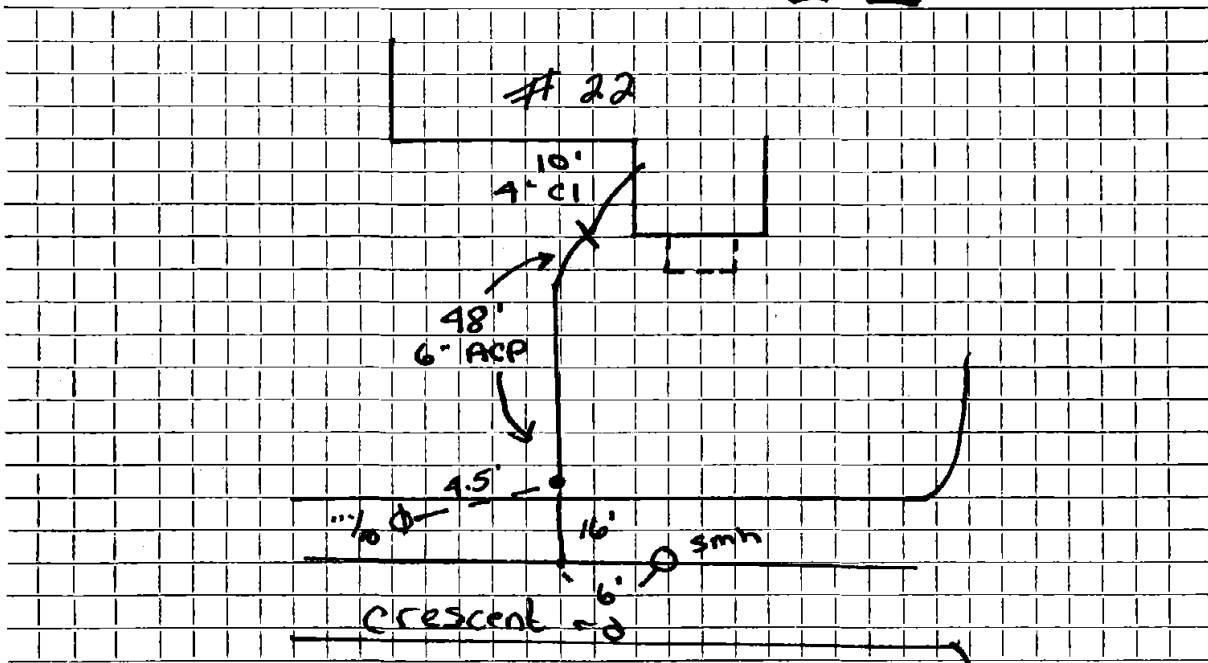

Connection made in Street. Work completed

Remarks:
.....
.....