


DATE 12/1/89

TOWN OF LEXINGTON — BOARD OF PUBLIC WORKS
SEWER DIVISION

Sketch of Service Here

5

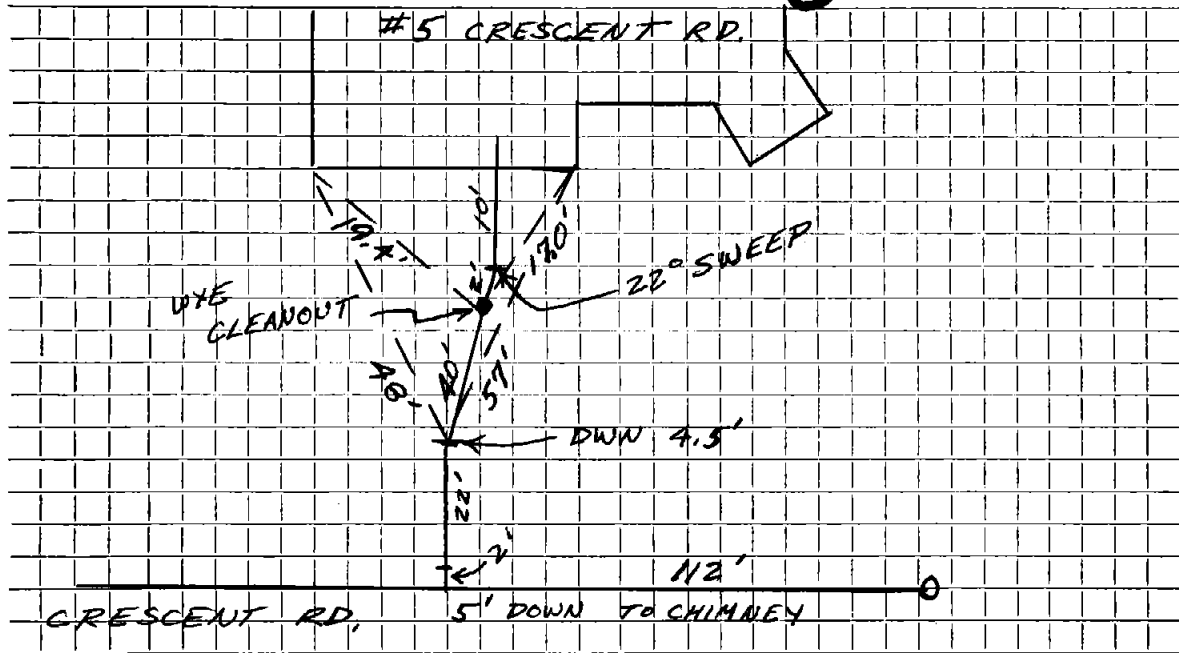

Connection made in CRESCENT RD. Street. Work completed

Remarks: INSP. CRG.