

Name

Service No.

Address # 9 CRESCENT RD.

Location

Kind of Pipe AC

Size 6"

Size of Main 8"

Repair—Renewal—New Service ✓

Location

Date

Material

Amount

Total

Date

Amount

~~8/10/78~~

~~25' 6" AC~~

~~\$14~~

~~\$350~~


8-18-78

25' 6" A.C.

DATE \_\_\_\_\_

TOWN OF LEXINGTON — BOARD OF PUBLIC WORKS  
SEWER DIVISION

Sketch of Service Here **9**

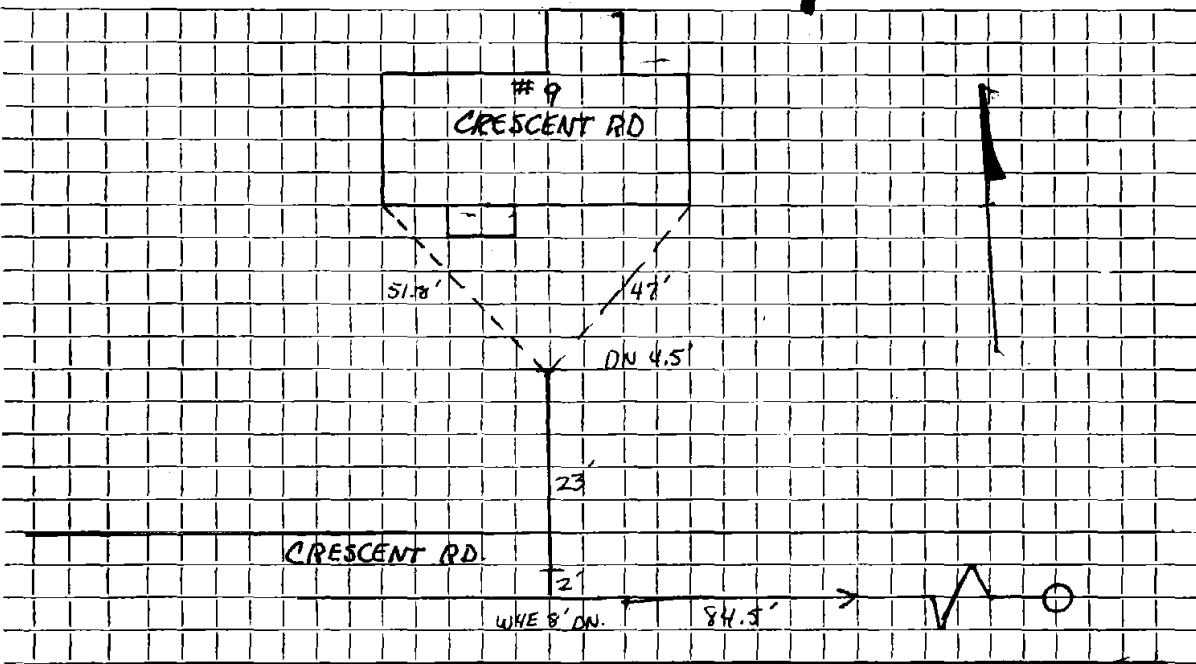

Connection made in ..... Street. Work completed .....

Remarks: .....  
.....  
.....