


DATE MAY 1983

TOWN OF LEXINGTON — BOARD OF PUBLIC WORKS
SEWER DIVISION

Sketch of Service Here

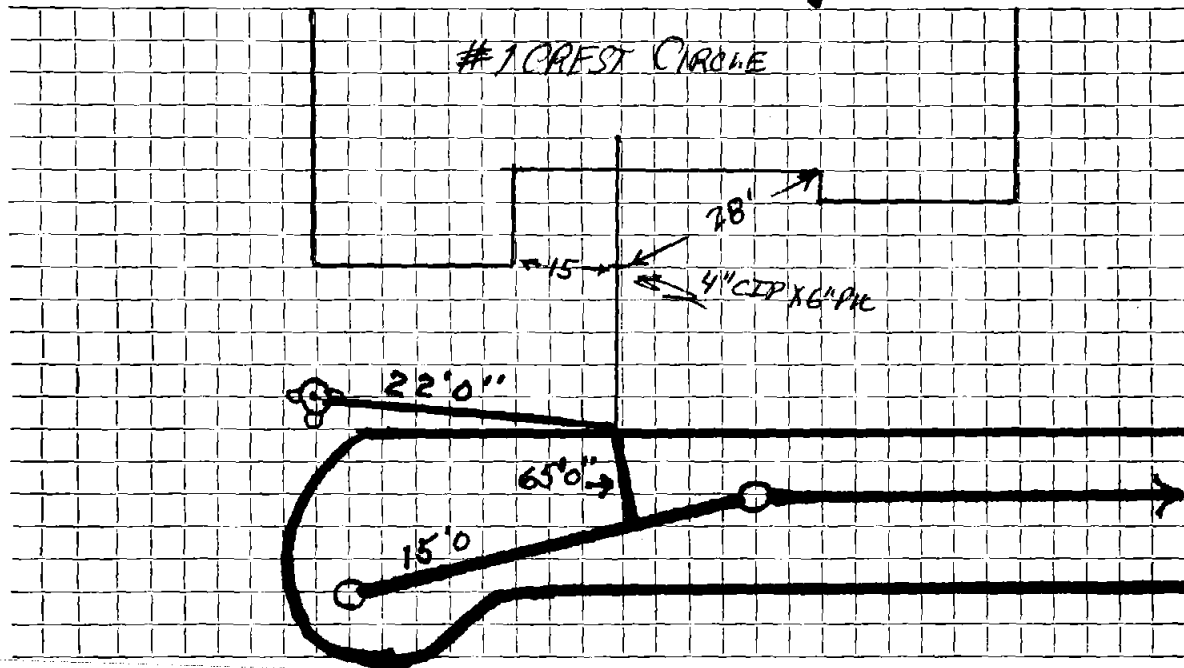

Connection made in CREST CIR Street.

Work completed MAY 1983

Remarks: