

Name Fred Robicheau

Service No. 146

Address 3 Crosby Road

Location

Kind of Pipe

Size

Size of Main

~~Repair/ Renewal~~ — New Service

Location

Cumra 11-30-59

Date	Material	Amount	Total	Date	Amount
9-16-59	Labor	71 14		9-16-59	71 14
9-17-59	"	21 74		9-17-59	21 74
		92 88			92 88
	10% O. H.	9 29	102 17		
59	6" Transite pipe @.70		41 30		
5	Hrs. Town Shovel @6.50		32 50	1-21-64	19 30
3	Hrs. Trucking @.75		2 25	1-22-64	14 84
1	Hr. Trucking @3.00		3 00	7-25-61	
1	Hr. Rogers Trailer @3.00		3 00		
	23 x 4 Patch		23 00		
			207 22	7-25-61	
					REPAIRED BY
					SS TOCCI

Deposit

Retained

L.B.

L.B.


Blockages at the water RESPONSE

DATE _____

TOWN OF LEXINGTON — BOARD OF PUBLIC WORKS

SEWER DIVISION

Sketch of Service Here

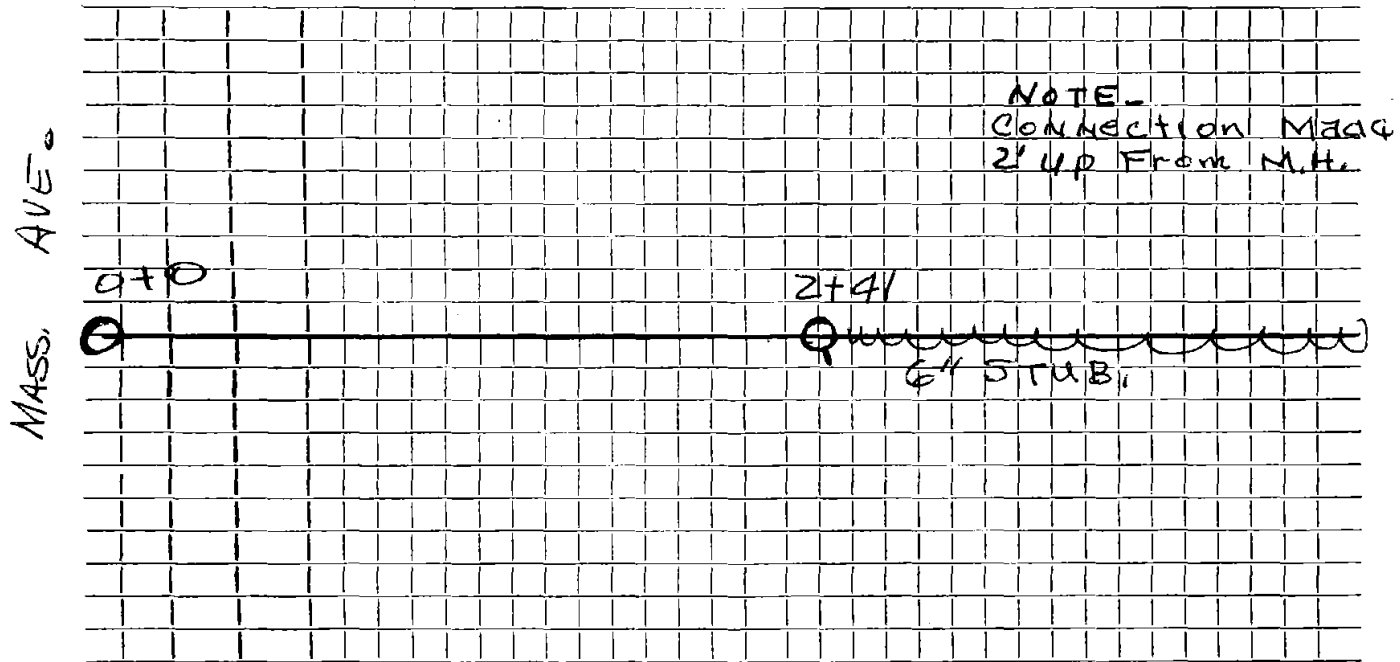

Connection made in Street. Work completed

Remarks:

Clear out installed by wall