




DATE \_\_\_\_\_

TOWN OF LEXINGTON — BOARD OF PUBLIC WORKS  
SEWER DIVISION

Sketch of Service Here

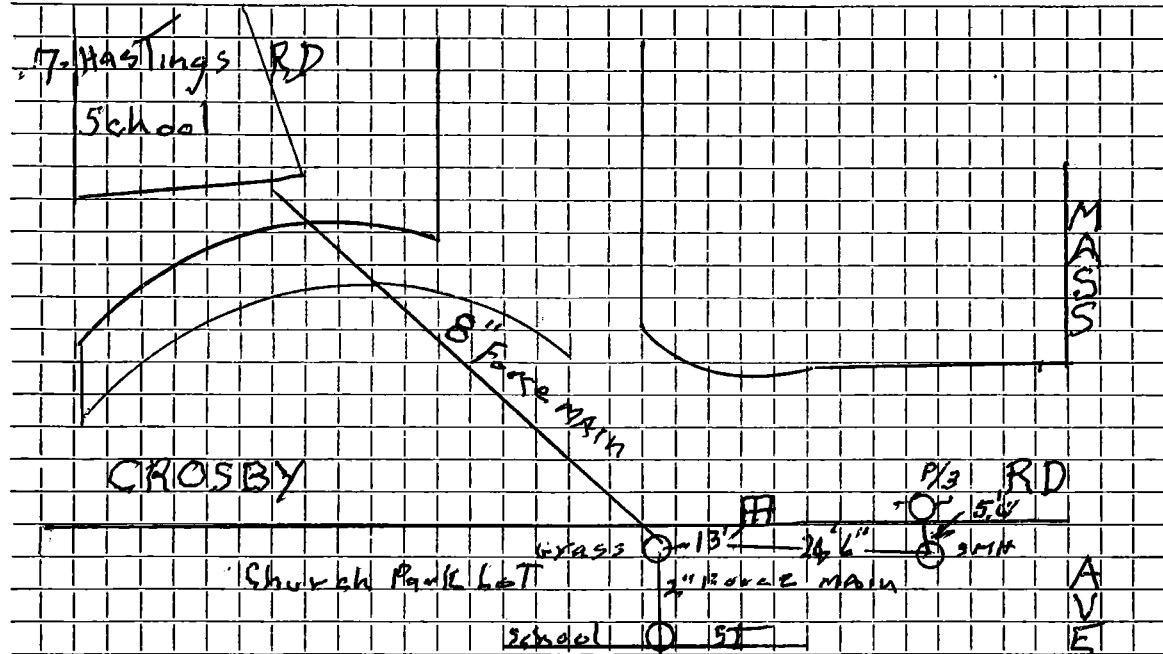

Connection made in Plumber's Pub. Sella Street. 2012 Work completed .....

Remarks: Clean out (N. Man hole) .....

.....

.....