

Name Ace Construction Co.

Service No. 14

Address 10 Cummings Avenue

Location

Kind of Pipe

Size

Size of Main

~~XXXXXX~~ New Service W.O. #8573

Location *Comm 5-18-64*

Date	Material	Amount	Total	Date	Amount
3-27-64	Labor	46 28		3-4-64	250 00
	10% O.H.	4 63	50 91	5-18-64	156 34
22'	6" Transite Pipe @.82		18 04		93 66
1	22½° Transite Bend		4 09		
1	6" Duplex Adapter		1 62		
2	Hrs. Town Shovel @6.50		13 00		
2	Hrs. Trucking @3.00		6 00		
			93 66		


Deposit
Refund

DATE _____

TOWN OF LEXINGTON — BOARD OF PUBLIC WORKS
SEWER DIVISION

Sketch of Service Here

10

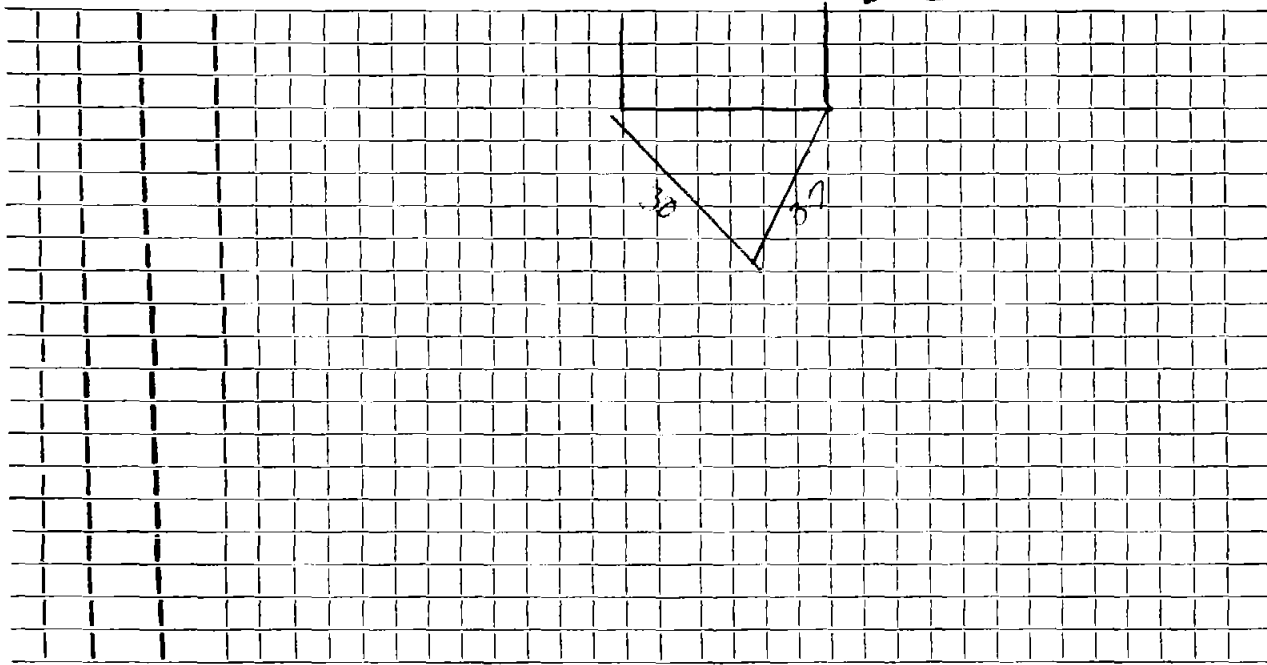

Connection made in Street. Work completed

Remarks:
.....
.....