

Name

Service No.

Address *1 CURRIER COURT*

Location

Kind of Pipe

Size

Size of Main

Repair—Renewal—New Service

NEW SERVICE

Location

Date

Material

Amount

Total

Date


Amount

12/12 94 43' OF 6" PVC

DATE 12/12/94

TOWN OF LEXINGTON — BOARD OF PUBLIC WORKS
SEWER DIVISION

Sketch of Service Here

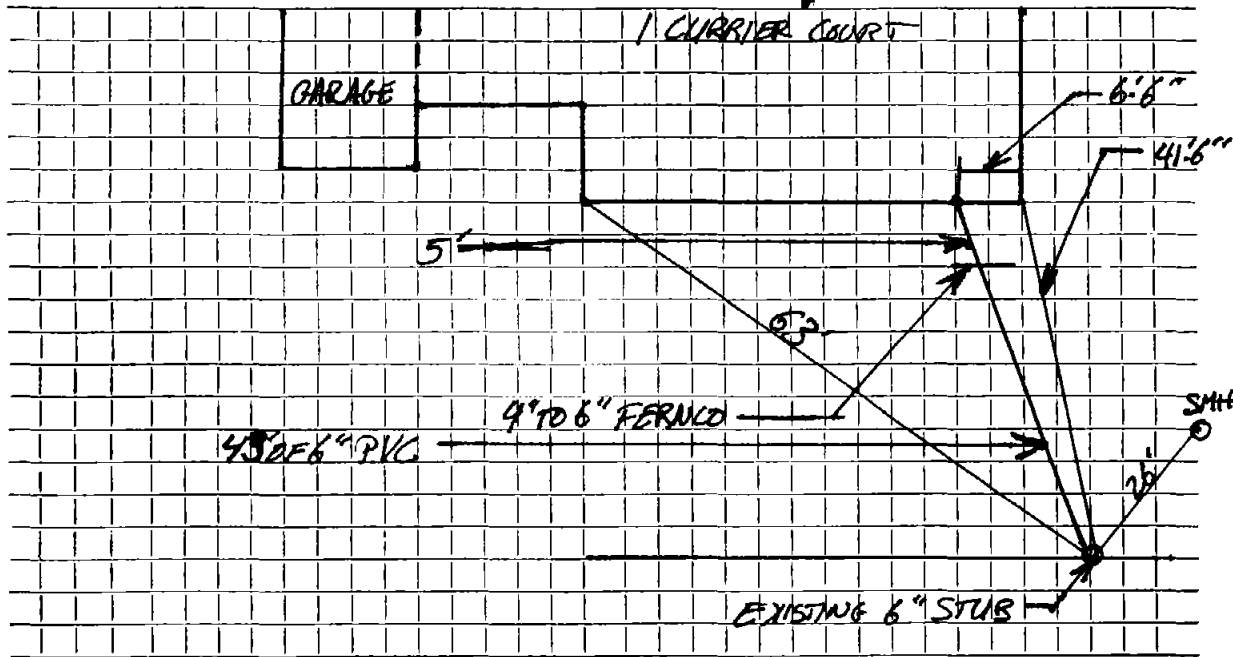

Connection made in Street. Work completed

Remarks:
.....
.....