

Name

Service No.

Address

3 CURRIER COURT

Location

Kind of Pipe

Size

Size of Main

Repair—Renewal—New Service

NEW SERVICE

Location

Date

Material

Amount

Total

Date

Amount


12/15 94 63' RF 6" PVC
1-6" 22 1/2" BEND
1-4" TO 6" REDUCER

DATE 12/13/94

TOWN OF LEXINGTON — BOARD OF PUBLIC WORKS
SEWER DIVISION

Sketch of Service Here

3

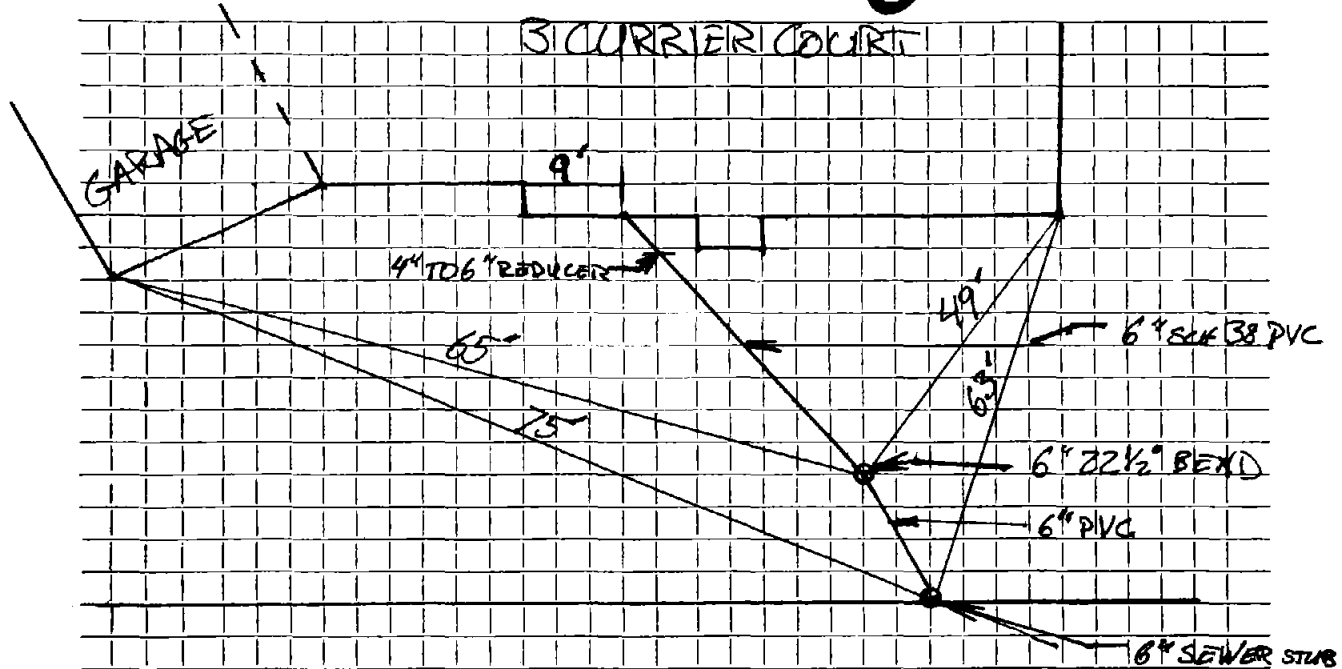

Connection made in Street. Work completed

Remarks:

.....

.....