

Name

Service No.

Address

5 CURRIER COURT

Location

Kind of Pipe

Size

Size of Main

Repair—Renewal—New Service

NEW SERVICE

Location

Date

Material

Amount

Total

Date

Amount

12/19 94 75' OF 6" PVC




DATE 12/19/94

TOWN OF LEXINGTON — BOARD OF PUBLIC WORKS

SEWER DIVISION

Sketch of Service Here

5

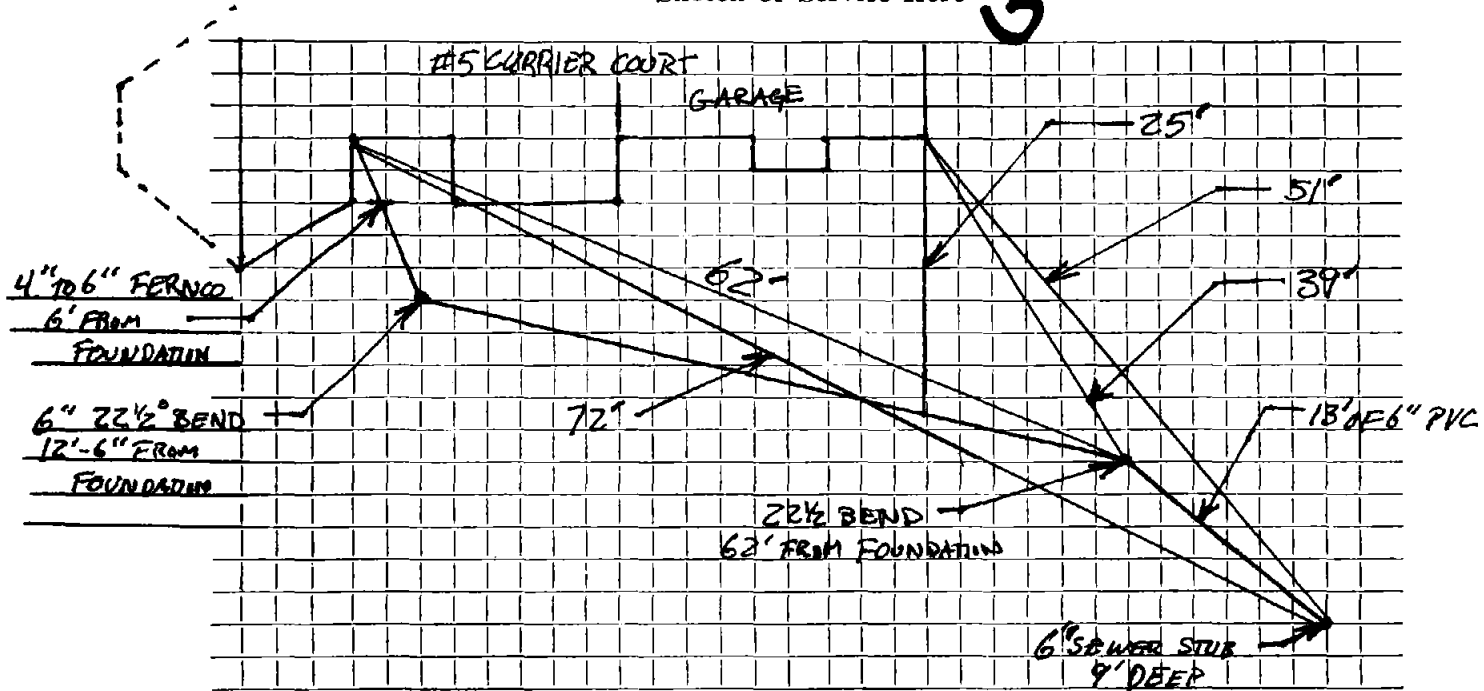

Connection made in Street. Work completed

Remarks:
.....
.....