
	A	T					
-	,,		-	 			

TOWN OF LEXINGTON - BOARD OF PUBLIC WORKS

SEWER DIVISION

Sketch of Service Here

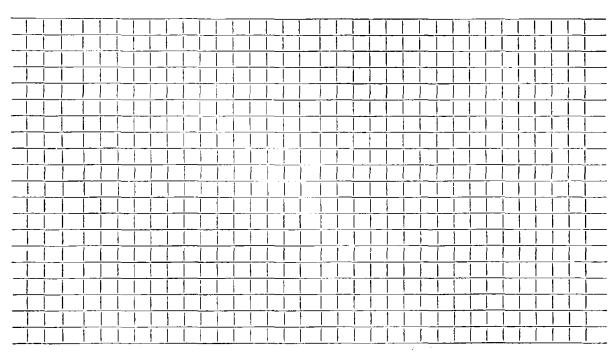

Connection made in	Street.	Work completed
Remarks:		
		,
	 	,,,,,,,,,,,,,,,,,,,,,,,,,,,,,,,,,,,,