

Name John & Eva Yanushkis

Service No. 8 209

Address 17/19 Curve St.

Location

Kind of Pipe

Size

Size of Main

~~Repair & Renewal~~—New Service

Location

Date	Material	Amount	Total	Date	Amount
0.2-18-30 for 81.07	44' 6" Sewer Pipe @.30	13 20			
	10' 4" Iron Pipe @.50	5 00		March 31 1930 - Cash	61 57
	Sulphur & Jute	1 56		Oct. 23 1930 - Cash	20 -
	Trucking	<u>75</u>	20 51		
	Comp. breaking frost, 4 hrs.		10 00	A.R. 10-1-30.	
10/30/29	60 Hrs. Labor @.55	33 00			
	5 " " @.60	3 00			
	12 " " @.70	<u>8 40</u>	44 40		
	15% Overhead		<u>6 66</u>		
	Labor		<u>81 57</u>		

Hadley Press, Inc. Lexington

TOWN OF LEXINGTON—BOARD OF PUBLIC WORKS
SEWER DIVISION

DATE _____

NO. _____


The undersigned applies for the construction of a particular sewer connecting No. _____ Street and hereby agrees to comply with the Rules and Regulations governing the construction and use of Particular Sewers, as now or at any future time established by the Board of Selectmen.

Am't. of Estimate \$ _____

Am't. Paid \$ _____

Owner

Sketch of Service Here

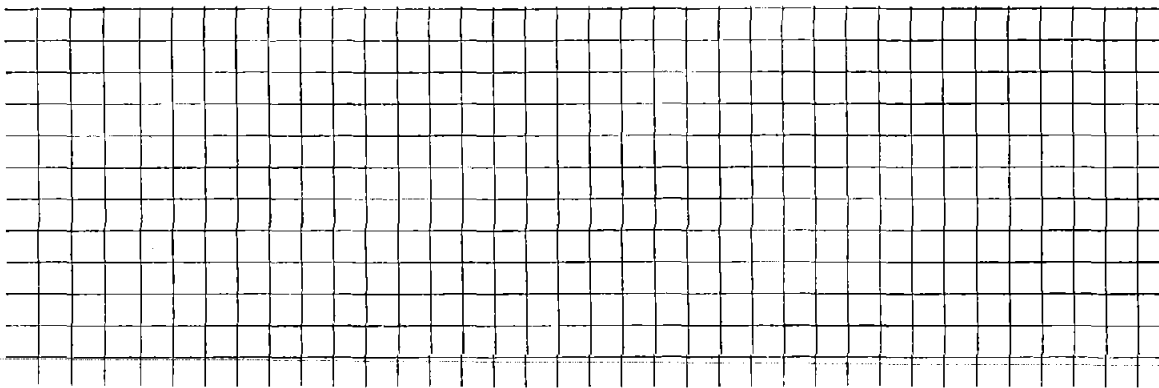

Connection made in _____ Street.

Work completed _____ 19

Remarks: