

Name Manual Aruda

Service No. 137

Address 22 Curve Street

Location

Kind of Pipe

Size

Size of Main

~~Repair - Renewal~~ New Service W.O. #7571

Location Comm 10-29-62


Date	Material	Amount	Total	Date		Amount
9-4-62	Labor	59.29		8-29-62	Deposit	200 00
	10% O.H.	5.93	65.22	10-29-62	Re Sand	25 94
	52' 6" Transite pipe @82		42.64			174 69
	1 6" Transite Tee		4.09			
	1 11 1/4" Transite Bend		4.09			
	20X3 Patch		20.00	9-5-62	NON CHARGE Labor	28.31
	4 Hrs. Town Shovel @6.50		26.00		10' 6" Transite Pipes @82	
	3 Hrs. Trucking @3.00		9.00			8.20
	1 Hr. Loader @3.00		3.00			36.51
			174.04			

DATE _____

TOWN OF LEXINGTON — BOARD OF PUBLIC WORKS
SEWER DIVISION

Sketch of Service Here

22

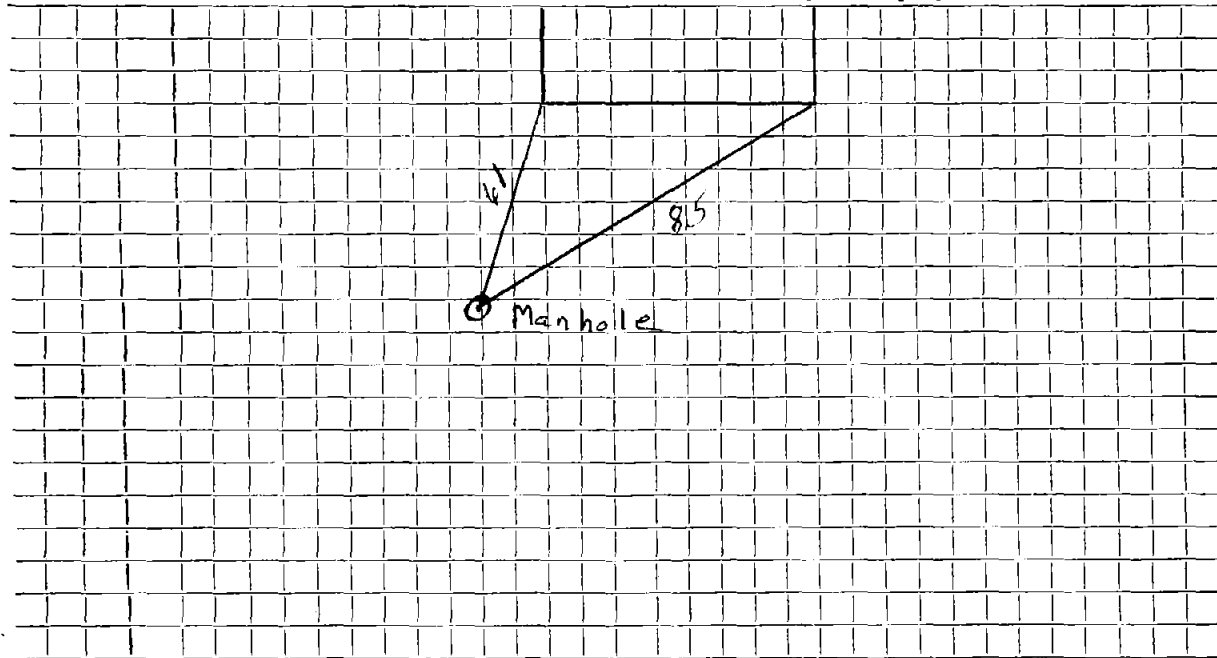

Connection made in Street. Work completed

Remarks:

.....

.....