

Name James Donahue

Service No. #83

Address 25 Curve Street

Location

Kind of Pipe

Size

Size of Main

Repair—Renewal—New Service WO #7364

Location Comm 10-1-62


Date	Material	Amount	Total	Date	Amount
6-21-62	Labor	46.76		6-19-62	Deposit 150.00
	10% O.H.	4.68	51.44	10-1-62	Retard 28.43
	31' 6" Transite Pipe @78		24.18		121.57
	2 22 $\frac{1}{2}$ ⁰ Transite Bends @4.09		8.18		
	2 11 $\frac{1}{4}$ ⁰ Transite Bends @4.09		8.18		
	1 90 ⁰ Transite Elbow		4.09		
	3 Hrs. Town Shovel @6.50		19.50		
	2 Hrs. Trucking @2.00		4.00		
			121.57		

DATE _____

TOWN OF LEXINGTON — BOARD OF PUBLIC WORKS

SEWER DIVISION

Sketch of Service Here

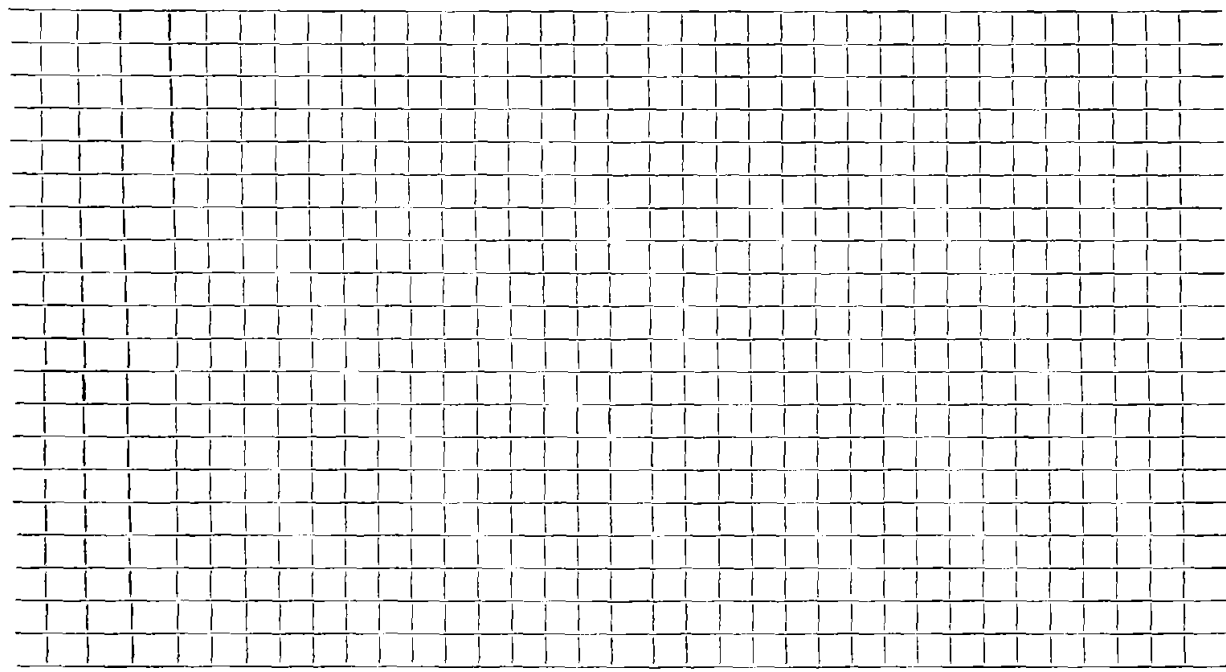

Connection made in Street. Work completed

Remarks:
.....
.....