


DATE _____

TOWN OF LEXINGTON — BOARD OF PUBLIC WORKS
SEWER DIVISION

Sketch of Service Here **27**

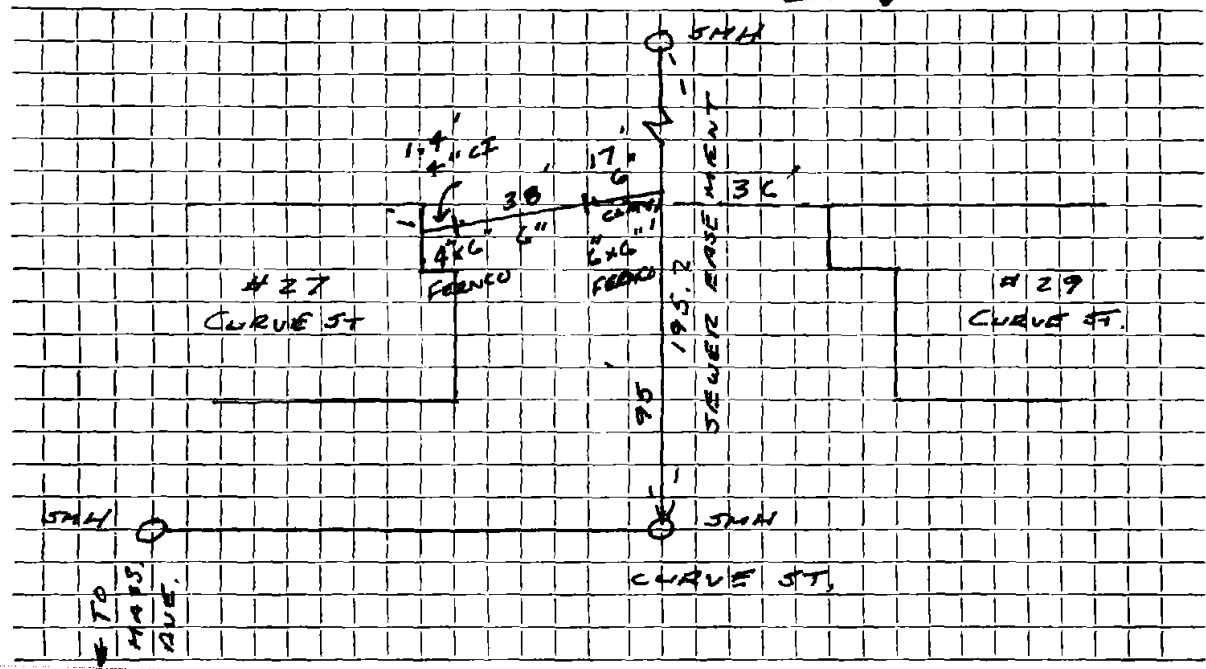

Connection made in EASEMENT Street. Work completed

Remarks: 17 LF EXIST. 6\"' CLAY Original Service 5-26-29