

Name Alvin Fradette

Service No. 1079

Address 29 Curve Street.

Lexington, M. ss.

Location 29 Curve Street

Kind of Pipe

Size

Size of Main

~~Repair~~ ~~Renewal~~ New Service

Location

Date		Material	Amount		Total	Date		Amount	
June 12	'47	Labor	54	90		June 4 '47	Deposited	85	00
13		"	3	00	57	Nov. 29 '47	Expended	2	70
		10% Overhead			5			82	30
		44' - 6" Sewer Pipe @.26			11				
		1 - 6" Elbow			1				
		Joint Compound			2				
		Compressor 1 hr. @1.75			1				
		Trucking 3 hrs. @.75			1				
					82				
					75				
		<b>Labor</b>							
		Nov 11 20 47				2-18-85	S.B. Paper in M.H		
						3-12-07	Blockage In main 85'		
							From m. it. #84		JM

TOWN OF LEXINGTON—DEPT. OF PUBLIC WORKS

SEWER DIVISION

DATE .....

NO. ....


The undersigned applies for the construction of a particular sewer connecting No. ....  
Street and hereby agrees to comply with the Rules and Regulations governing the construction and use of Particular  
Sewers, as now or at any future time established by the Board of Selectmen.

Am't of estimate \$.....

Am't Paid \$.....

..... Owner

Sketch of Service Here **29**

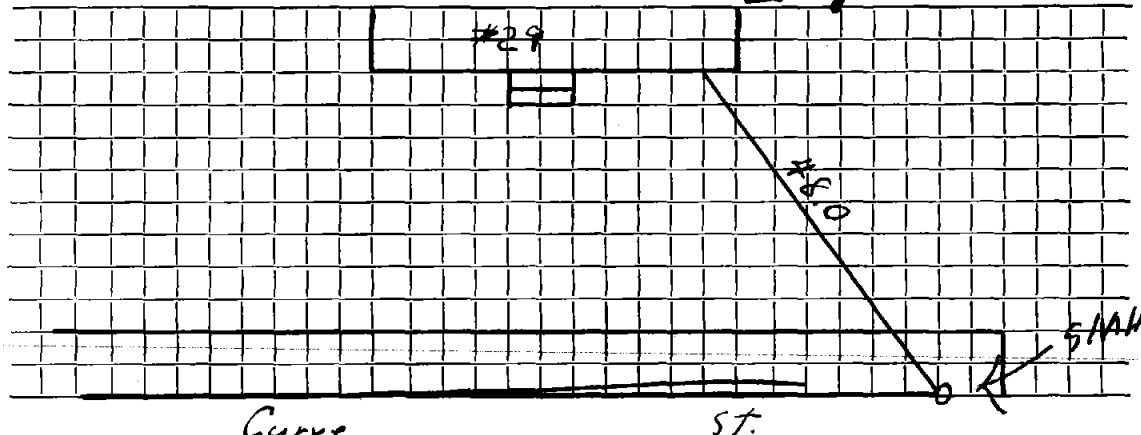

Connection made in ..... Street. Work completed ..... 19..

Remarks: