




DATE \_\_\_\_\_

TOWN OF LEXINGTON — BOARD OF PUBLIC WORKS  
SEWER DIVISION

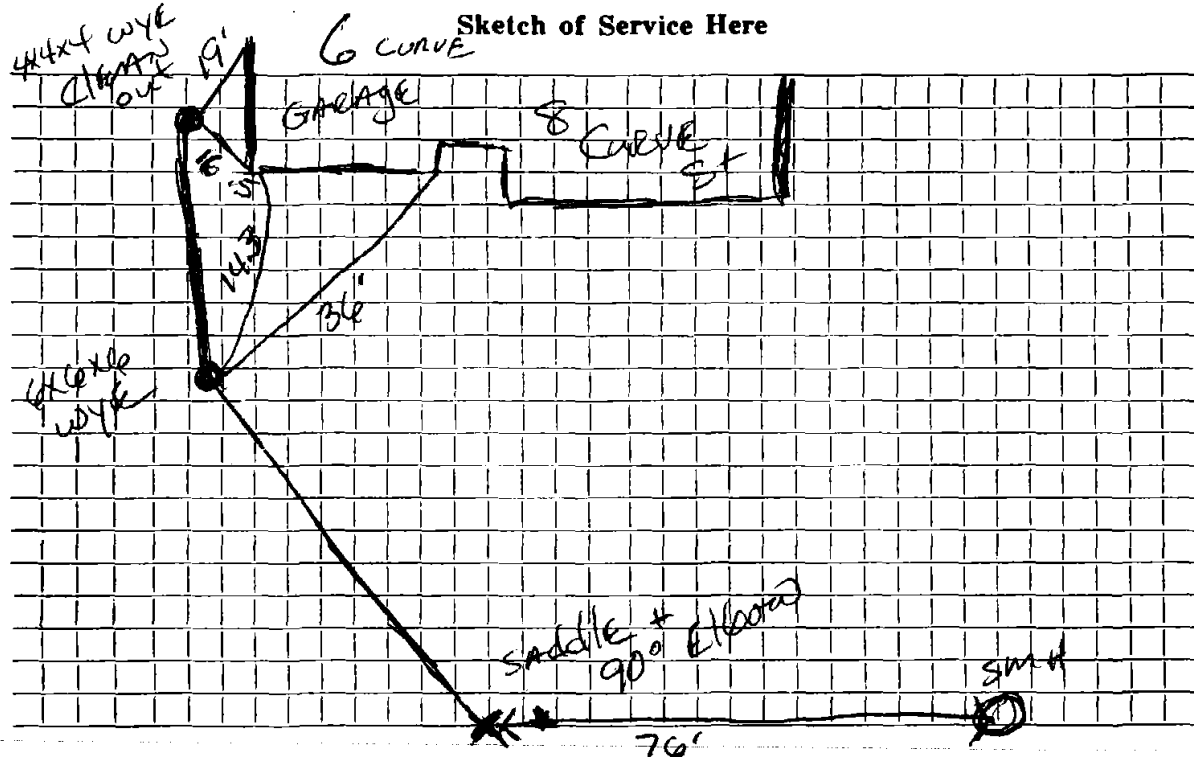

Connection made in ..... Street. Work completed .....

Remarks: House has separate service for new addition  
old clay wye 72' from M.H.