

Name

Service No.

Address

8 CURVE ST

Location

Kind of Pipe

Size

Size of Main

Repair—Renewal—New Service

Location

Date

Material

Amount

Total

Date

Amount

4-20-01

10' 4" PVC

4x4x4 WYE CLEAN OUT

75' 6" PVC

6" 45° BEND

6x6x6 PVC WYE CLEAN OUT

6" 90° BEND


10" x 6" SADDLE

DATE _____

TOWN OF LEXINGTON — BOARD OF PUBLIC WORKS
SEWER DIVISION

Sketch of Service Here

8

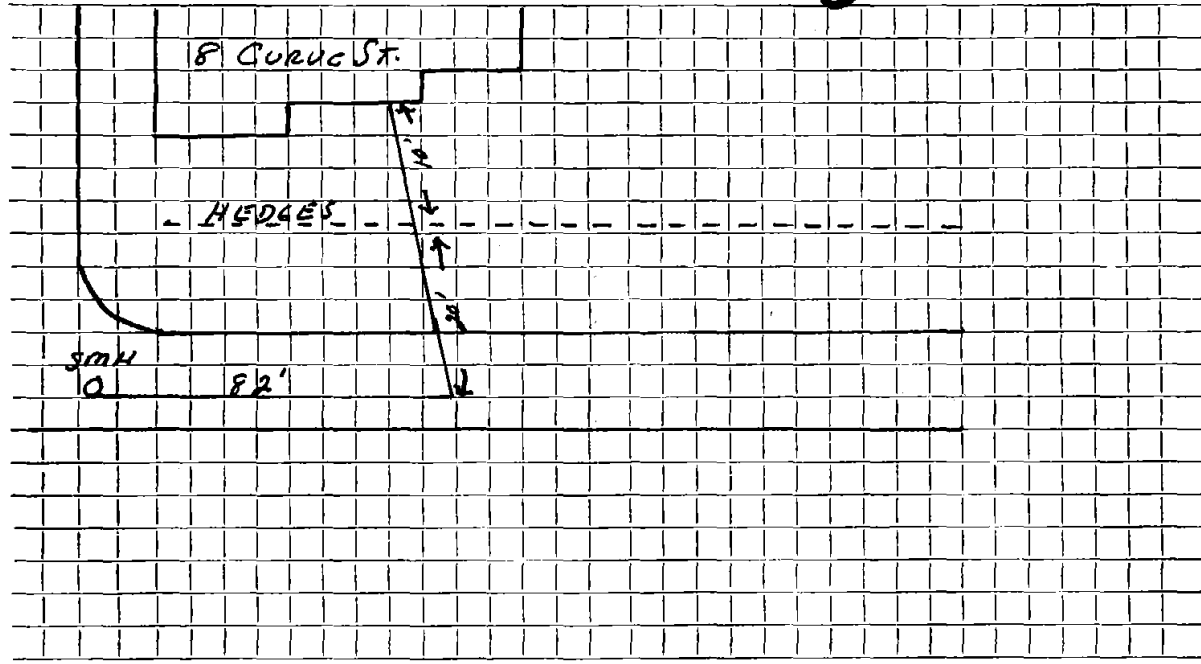

Connection made in Street. Work completed

Remarks:
.....
.....