

Name

Service No. 1739

Address 10 Cushing St

Location

Kind of Pipe PVC

Size 6"

Size of Main

Repair—Renewal—New Service Termination J McLaughlin


Location

Date	Material	Amount	Total	Date	Amount
5/11/05	6' 4" sch 40 PVC				
	36.6 6" PVC				
	1 4x6 Fernco				
	1 6" AC-xPVC Fernco				
	* exist AC.				

DATE \_\_\_\_\_

**TOWN OF LEXINGTON — BOARD OF PUBLIC WORKS**  
**SEWER DIVISION**

Sketch of Service Here

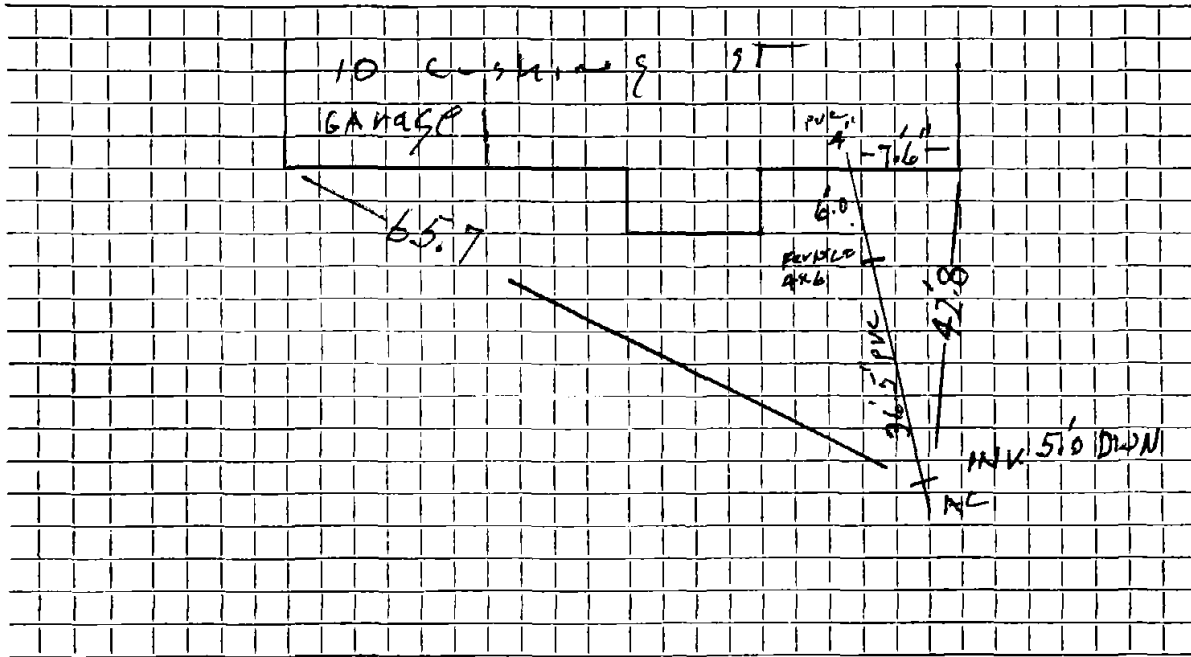

Connection made in ..... Street.

Work completed 5/11/09 J. McLaughlin

Remarks: .....  
.....  
.....