



Name Peter Lund

Service No. 59

Address 17 Cushing Street

Location

Kind of Pipe

Size

Size of Main

Repair—Renewal—New Service

Valeti #1403

Location SEP 2 1969

Date

Material

Amount

Total

Date

Amount

~~August 66~~ 17' @ \$5.00

\$85 00

6-24-69

Deposit

85.00

7-3-69 33' 6" Transite pipe

8- - 66

10' 4" Cast Iron pipe

17'


DATE \_\_\_\_\_

TOWN OF LEXINGTON — BOARD OF PUBLIC WORKS

SEWER DIVISION

Sketch of Service Here

17

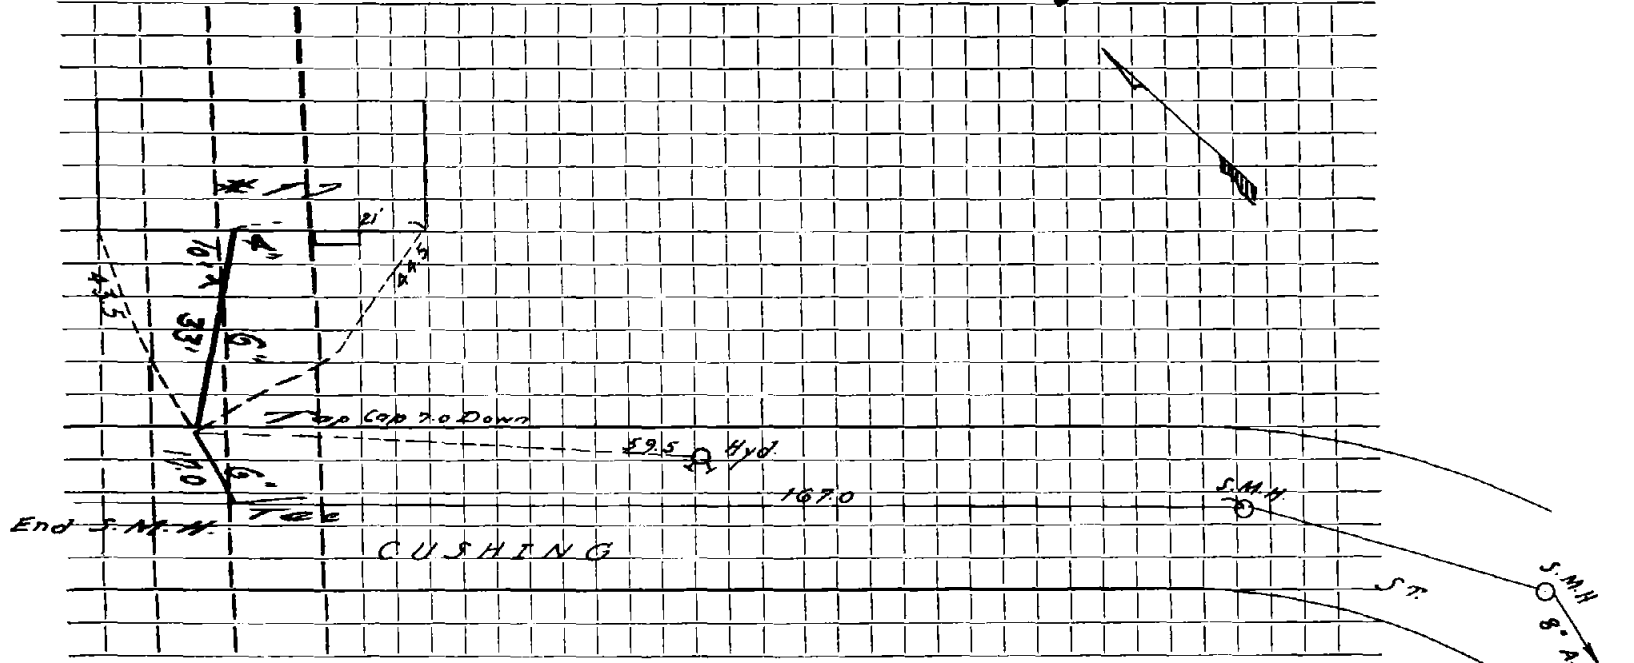


Connection made in ..... Street. Work completed .....

Remarks: .....

DATE April 23, 2002

TOWN OF LEXINGTON — BOARD OF PUBLIC WORKS  
SEWER DIVISION

Sketch of Service Here

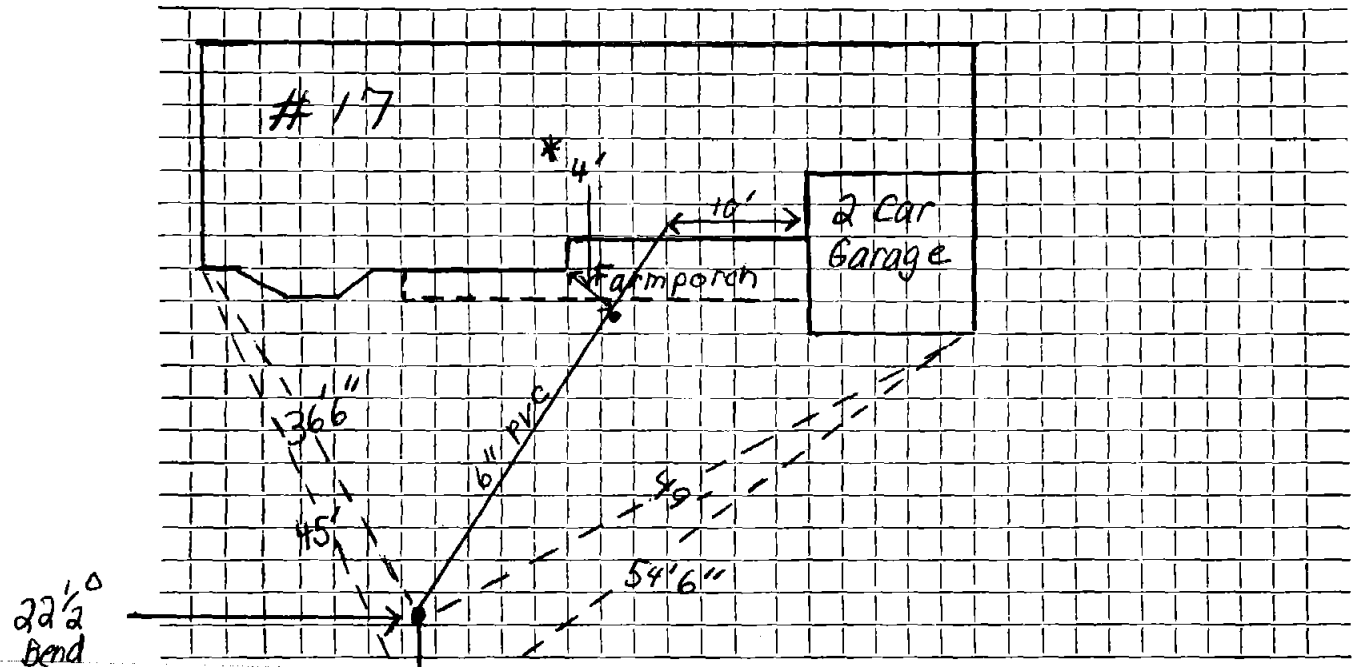

Connection made in ..... Street. Work completed .....

Remarks: ..... Existing Sewer Stub A.C. Depth 9' length Approx. 17' to main.....

\* 4x6 Fence 4' from Foundation wall.