


DATE 8/8/2019

TOWN OF LEXINGTON — BOARD OF PUBLIC WORKS
SEWER DIVISION

Sketch of Service Here

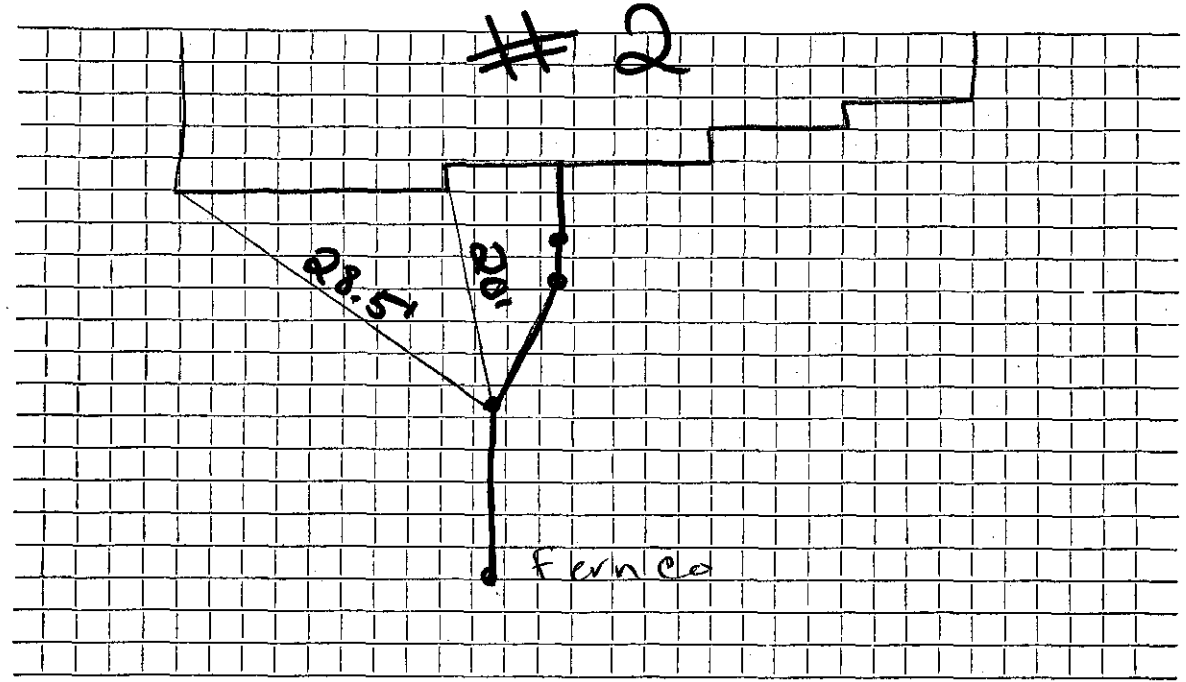

Connection made in Cushing Street. Work completed

Remarks: Cleanout inside as well. Farmers porch being put in
that's why cleanout is over 10' away.