

Name Richard Yacoubian

Service No. 55

Address 5 Cushing Street

Location

Kind of Pipe

Size

Size of Main

Repair—Renewal—New Service Valeri #1386

Location SEP 2 1969

Date Material Amount Total Date Amount

~~August 66~~ 21' @ \$5.00 \$105.⁰⁰ 6-17-69 Deposit 105.⁰⁰

7-2-69 121' 6" Transite pipe 8- - 66

4' 4" Cast Iron pipe 21'

4-30-04 Respond + MEASURE


170 3 100

DATE _____

TOWN OF LEXINGTON — BOARD OF PUBLIC WORKS SEWER DIVISION

Sketch of Service Here

5

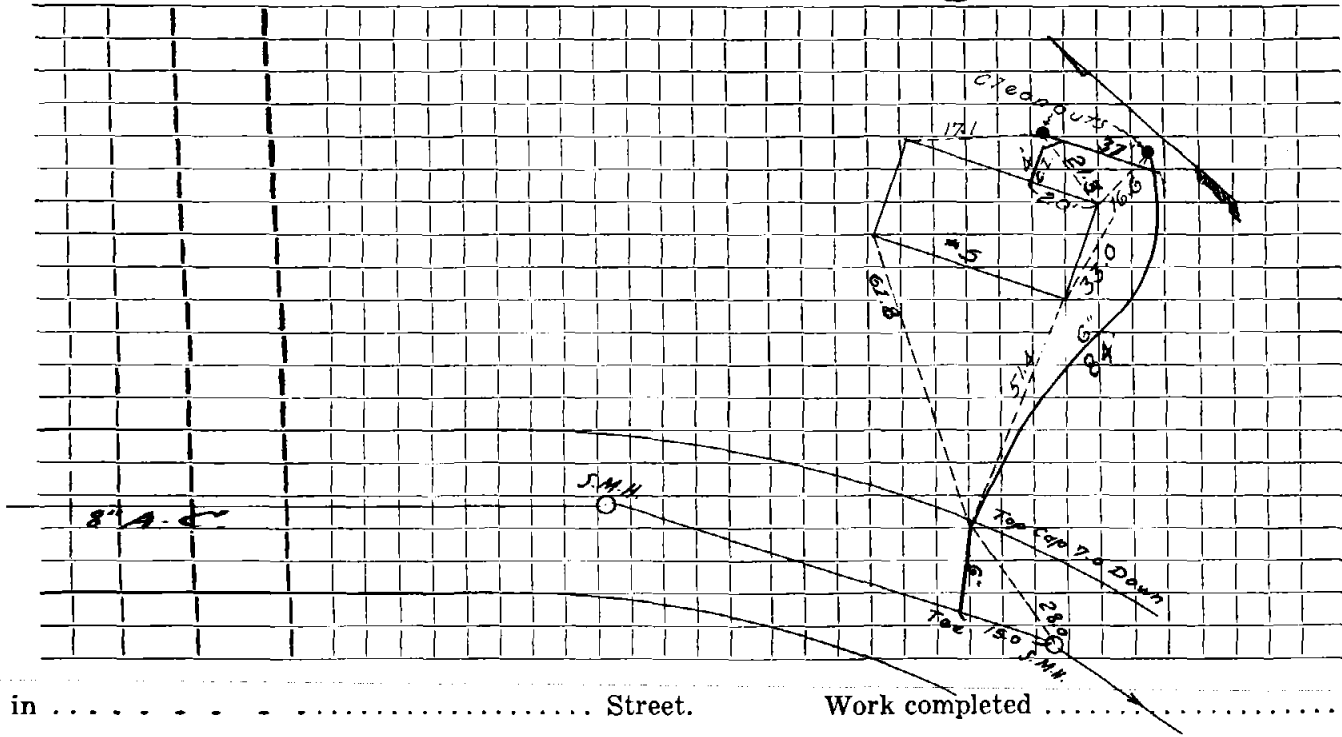

Connection made in Street. Work completed

Remarks:

.....
.....

