

WATER SERVICE RECORD

Name

Service No.

Address 7 CUTLER FARM RD

Location

Repair Renewal New Service

Date	Material	Amount	Total	Date		Amount
------	----------	--------	-------	------	--	--------

6" SDR

6" CLEAN OUT

6" PVC CAP

6" SDR RISER

6" TEE WYU

6" 45 BEND


6" 22 BEND

DATE _____

TOWN OF LEXINGTON — BOARD OF PUBLIC WORKS

WATER DIVISION
SEWER

Sketch of Service Here

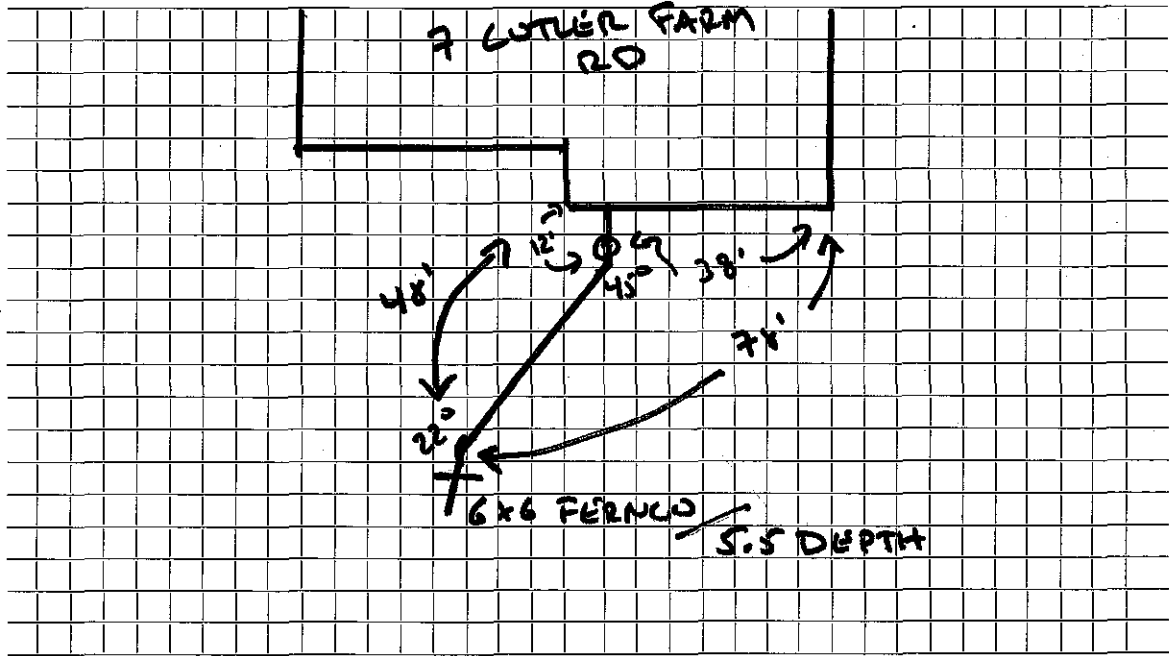

Connection made in ... CUTLER Street. Work completed

Remarks:

.....

.....