

Name

Service No.

Address 7 CUTLER FARM RD

FINNKAAN

Location

Kind of Pipe

Size

Size of Main

~~Repair~~ Renewal New Service

Location

Date

Material

Amount

Total

Date

Amount

9/20/12

- 6" SDR

- 6" CLEAN OUT

· 6" PVC CAP

· 6" SDR RISER

· 6" TRU WYE


- 6" 22° PVC BEND

- 6" x 6" FERRO

DATE 9/20/17

TOWN OF LEXINGTON — BOARD OF PUBLIC WORKS  
SEWER DIVISION

Sketch of Service Here

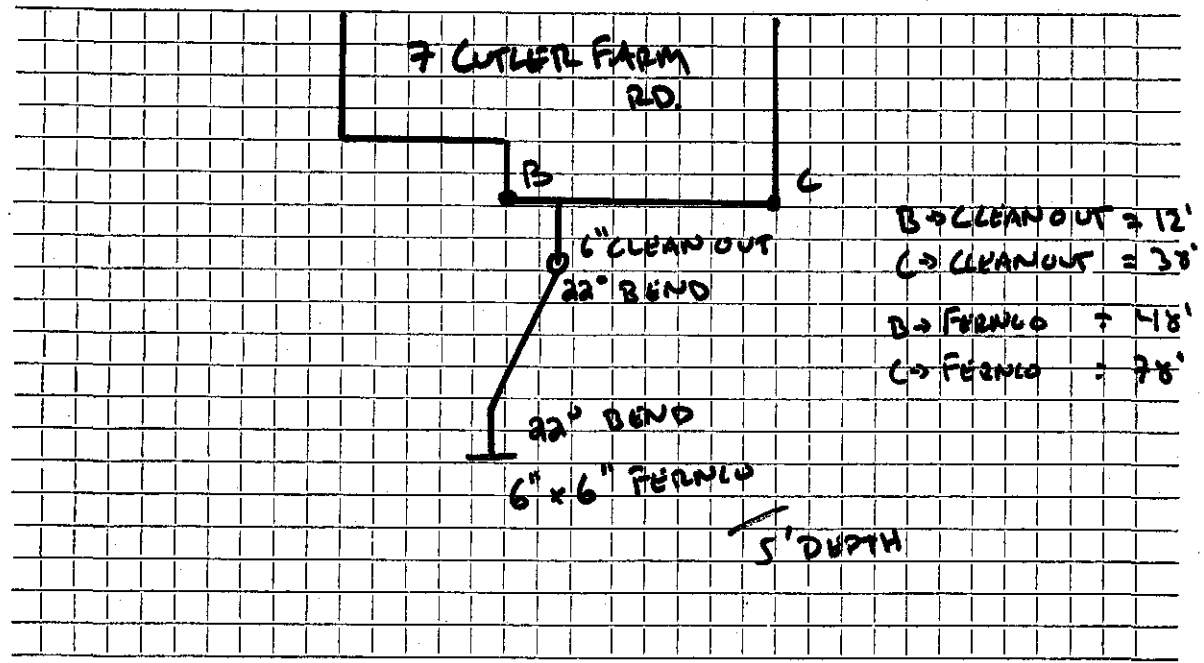

Connection made in CUTLER FARM Street. Work completed FINNEGAN

Remarks: .....

.....

.....