

Name Arthur P. Hill

Service No. 132

Address 11 Cutler Farm Road

Location

Kind of Pipe Craftsman inc. Permit #A202

Size

Size of Main

Repair ~~Renewal~~ — New Service

Location

MAY 2 1966

Date	Material	Amount	Total	Date	Amount
<del>7-30-64</del>	<del>23' 6" Transite pipe @5.00</del>		115.00	<del>8-13-65</del>	<del>115.00</del>
3-28-66	26' 6" Transite pipe				
2-8-	94 New Service			7-30-64	
	35' 6" PVC			23' 6" Transite	
	6' 4" PVC				
	1 6"X6" Fernco				
	1 6"X4" Fernco				
	1 6"-22° Elbow				

*Deposit*


*115.00*

DATE \_\_\_\_\_

# TOWN OF LEXINGTON — BOARD OF PUBLIC WORKS

## SEWER DIVISION

Sketch of Service Here *//*

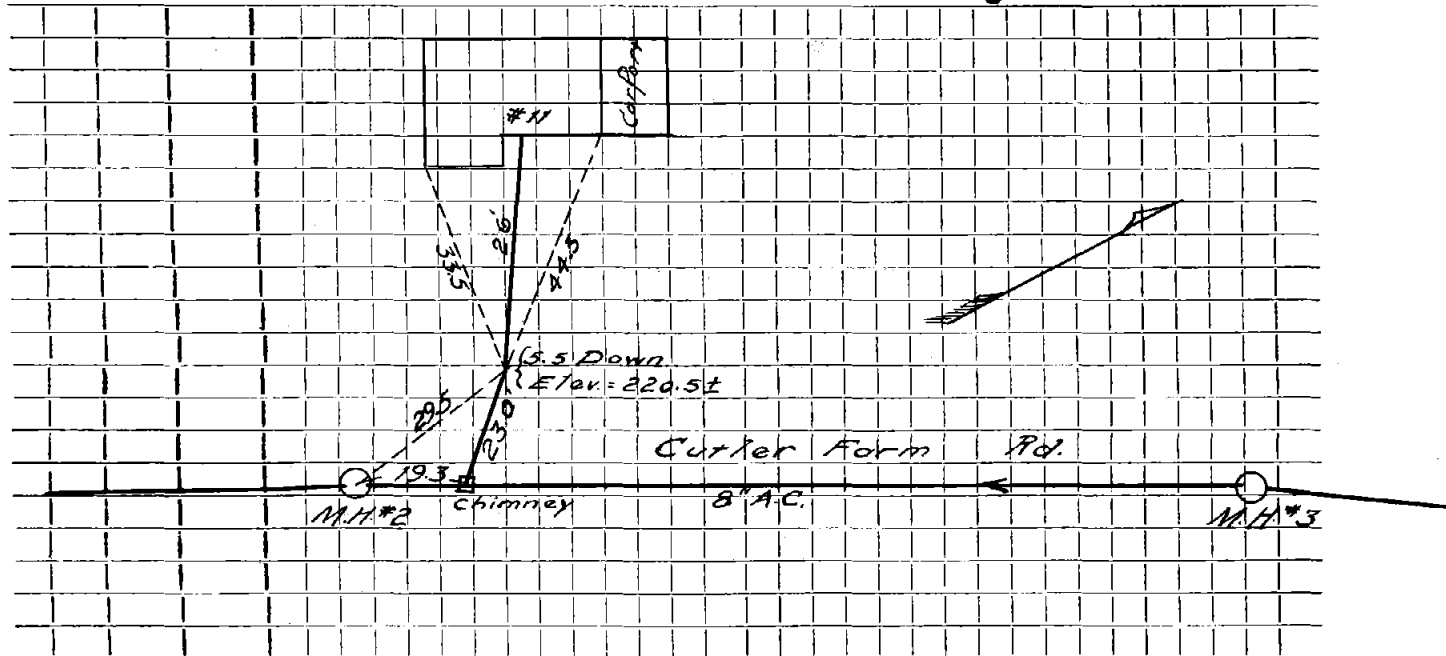

Connection made in ..... Street. Work completed .....

Remarks: .....